



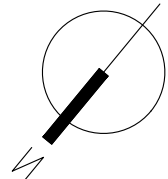

Site Plan at First Floor Level
scale 1:200

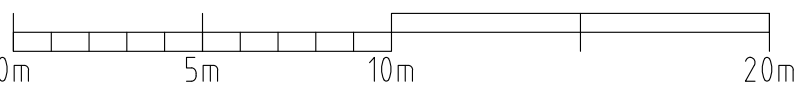

NOTE:
MEASURE & CHECK ALL DIMENSIONS
ON SITE TO CONFIRM LAYOUT PRIOR TO
CONSTRUCTION

PRELIMINARY DRAWING
NOT FOR CONSTRUCTION

AS CONSTRUCTED
AS AT 22.02.2024

NOTE:
THESE ARE CAD CONVERSION DRAWINGS
FROM IMPERIAL AND ARE
NOT TO BE USED FOR
CONSTRUCTION PURPOSES

REV	DESCRIPTION	DATE
A	PRELIMINARY ISSUE	25.03.2024

VISTA DESIGNS
Building Designers


SUITE 3, 279 LORD STREET
EAST PERTH 6004
TEL / FAX: 92277415
© COPYRIGHT

SWAN CARE RICHARD CLEAVER LODGE
34 Graham Cres,
BENTLEY WA 6102



Drawing Title
Site Plan at First Floor Level
Existing

Drawn	Scale	Date	Job No.	Drawing No.	Rev
	1:200@A2	25.03.24	3097	A1	A

Check all dimensions on site prior to commencement of any works
Unauthorized copying or distribution of this drawing is strictly
prohibited. Copyright © 2023

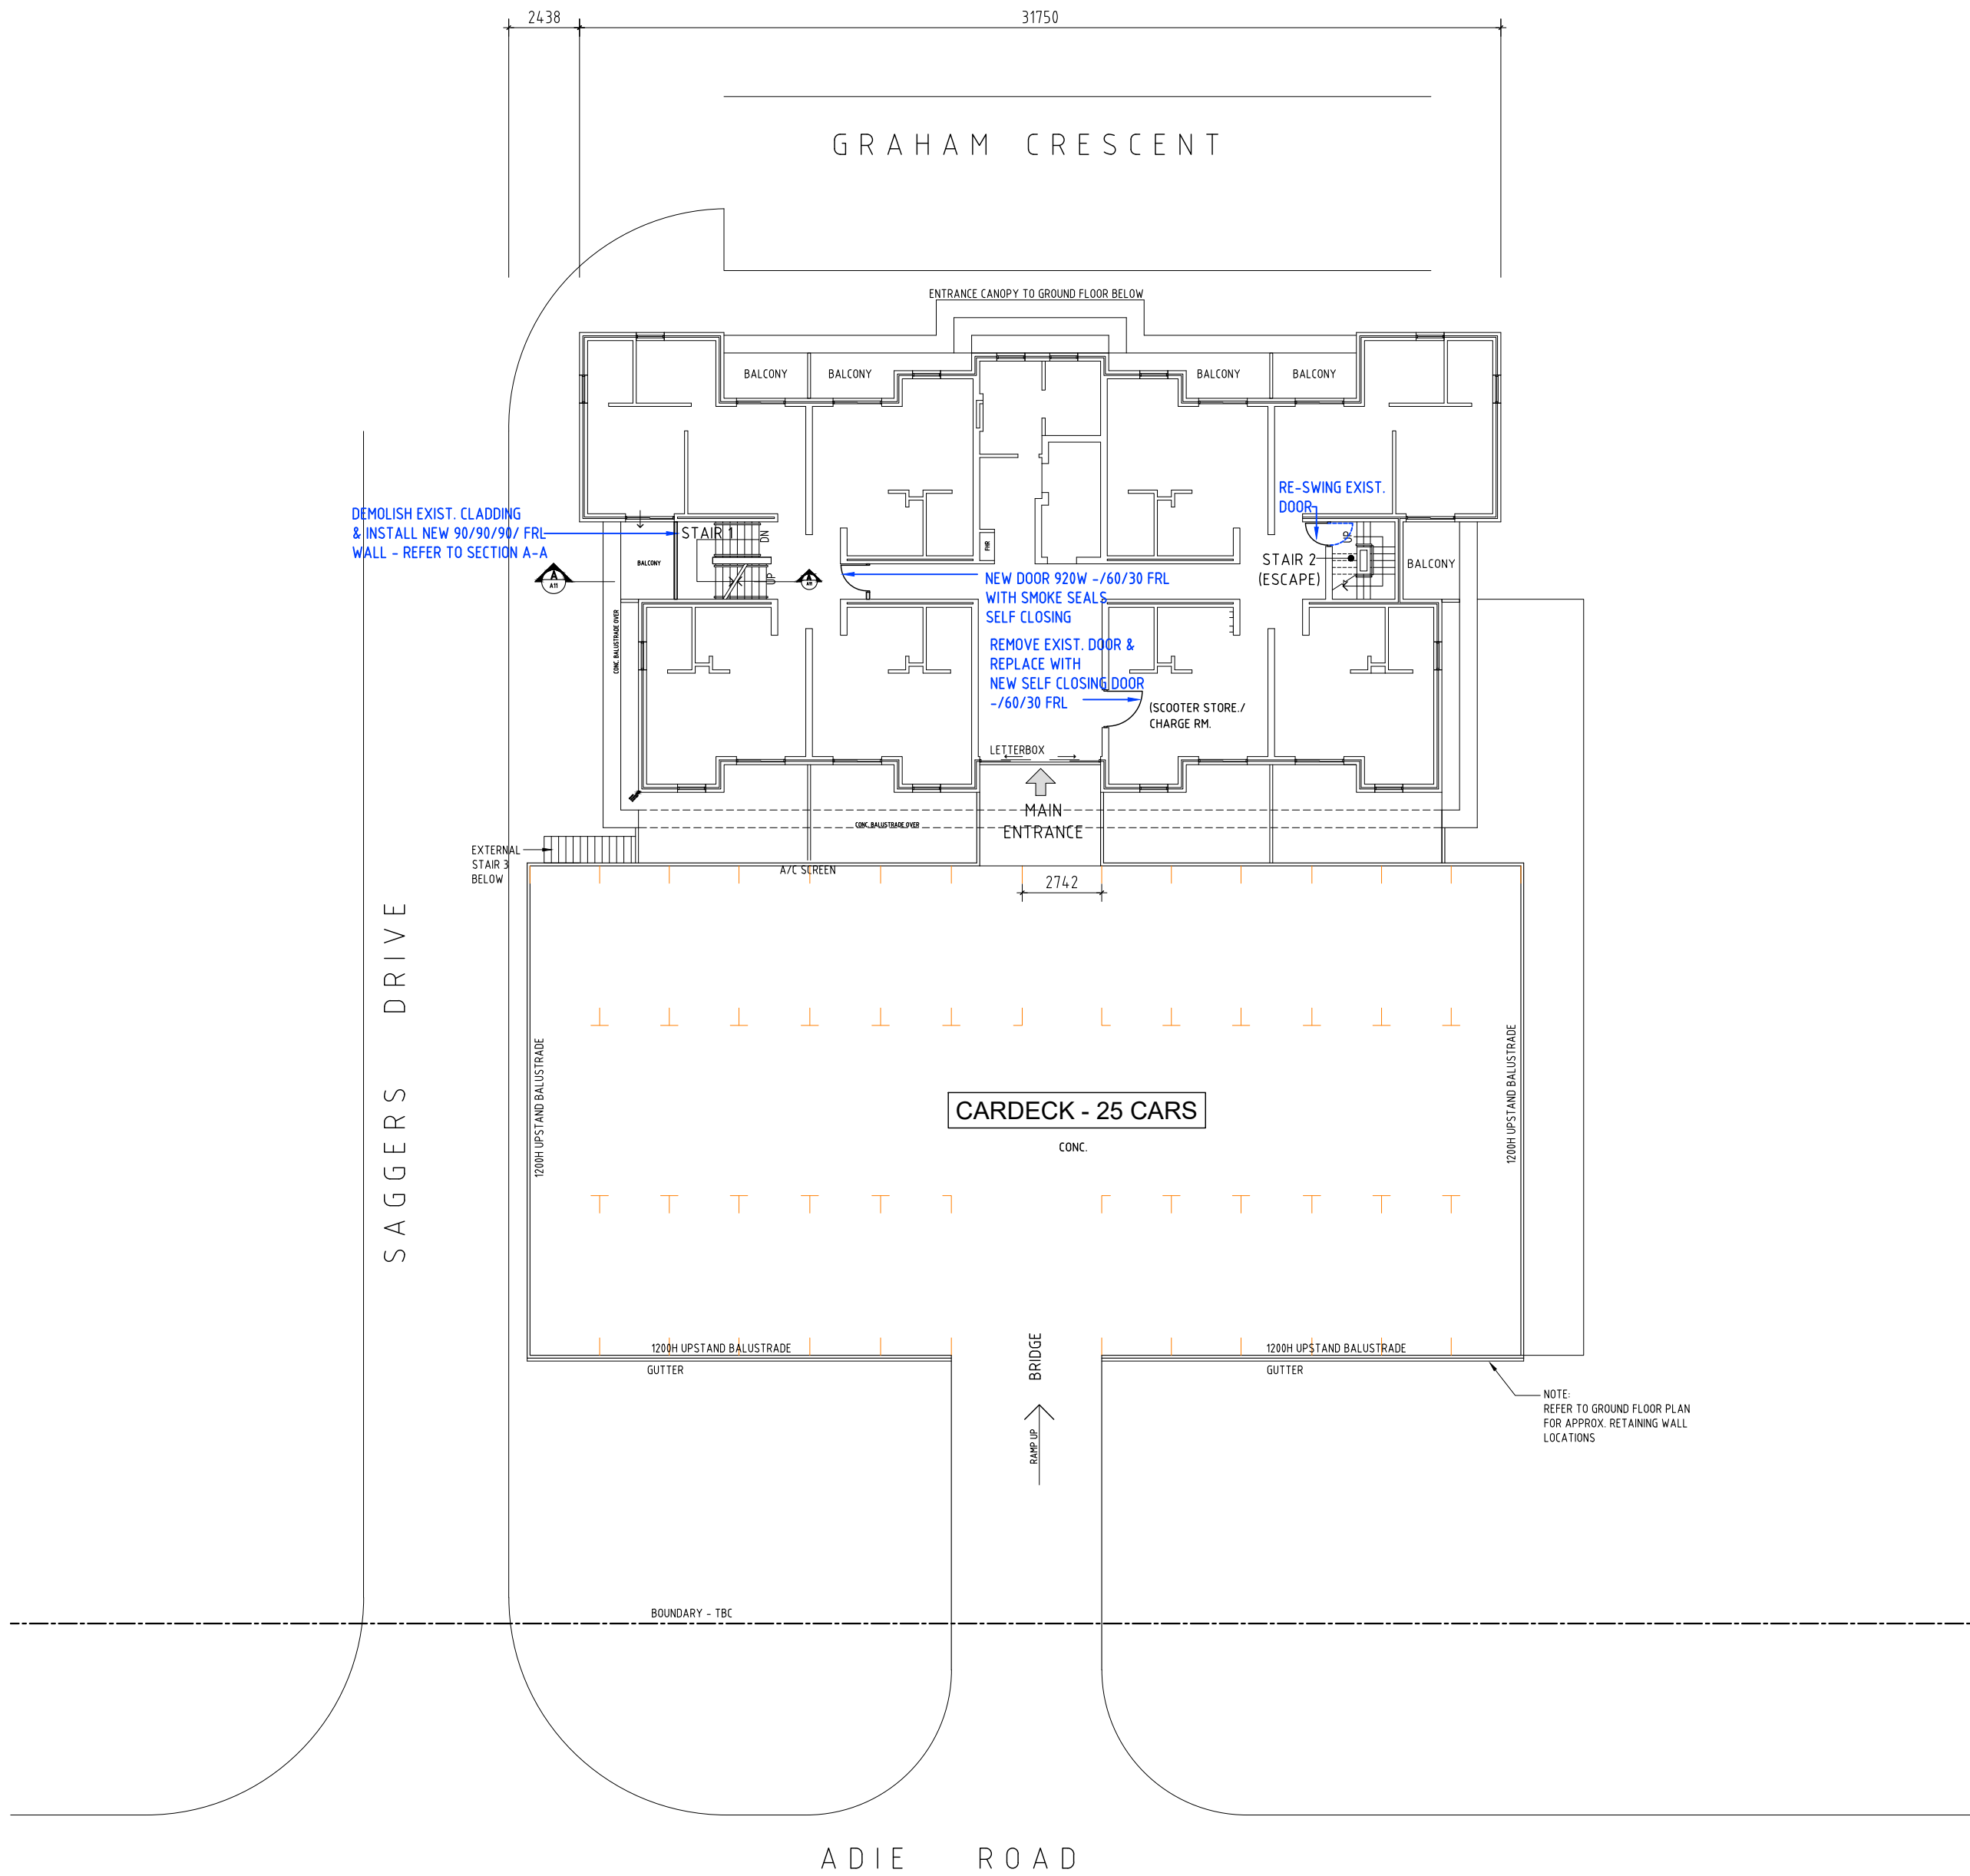

Site Plan at First Floor Level
scale 1:200

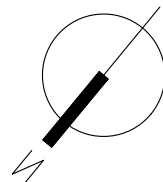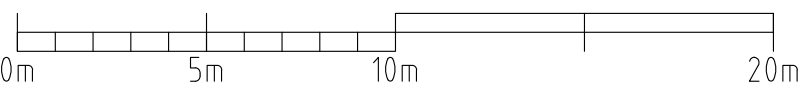

GENERAL NOTES

- PAINT TO ALL NEW WALLS & CEILINGS TO AS/NZS 2311:2017
- DO NOT SCALE DRAWING - DIMENSIONS TO GOVERN SCALE
- ALL DIMENSIONS ARE TO BE CHECKED ON SITE PRIOR TO THE COMMENCEMENT OF ANY WORK OR THE FABRICATION OF ANY ITEMS
- ALL MATERIALS ARE TO BE INSTALLED IN ACCORDANCE WITH THE 'NCC' & MANUFACTURER'S RECOMMENDATIONS UNLESS NOTED OTHERWISE
- EXTENT OF DEMOLITION NOT LIMITED TO AS STATED
- THIS DRAWING SHALL BE READ IN CONJUNCTION & COMPLY WITH THE FOLLOWING:
 - HVAC DRAWINGS BY OTHERS
 - ELECTRICAL DRAWINGS BY OTHERS
 - FIRE ENGINEER'S REPORT
 - AS 1428 CODE REQUIREMENTS
 - MANUFACTURER'S SPECIFICATIONS
 - 'NCC' REQUIREMENTS

PRELIMINARY DRAWING
NOT FOR CONSTRUCTION

NOTE:
THESE ARE CAD CONVERSION DRAWINGS
FROM IMPERIAL AND ARE
NOT TO BE USED FOR
CONSTRUCTION PURPOSES

REV	DESCRIPTION	DATE
A	PRELIMINARY ISSUE	25.03.2024

VISTA DESIGNS
Building Designers

SUITE 3, 279 LORD STREET
EAST PERTH 6004
TEL./FAX: 92277415
© COPYRIGHT


SWAN CARE RICHARD CLEAVER LODGE
34 Graham Cres,
BENTLEY WA 6102

Drawing Title
Site Plan at First Floor Level
Demolition / Proposed Upgrade


Drawn	Scale	Date	Job No.	Drawing No.	Rev
1200@A2	1:200	25.03.24	3097	A2	A

Check all dimensions on site prior to commencement of any works. Unauthorised copying or distribution of this drawing is strictly prohibited. Copyright © 2023

NOTE:
MEASURE & CHECK ALL DIMENSIONS
ON SITE TO CONFIRM LAYOUT PRIOR TO
CONSTRUCTION

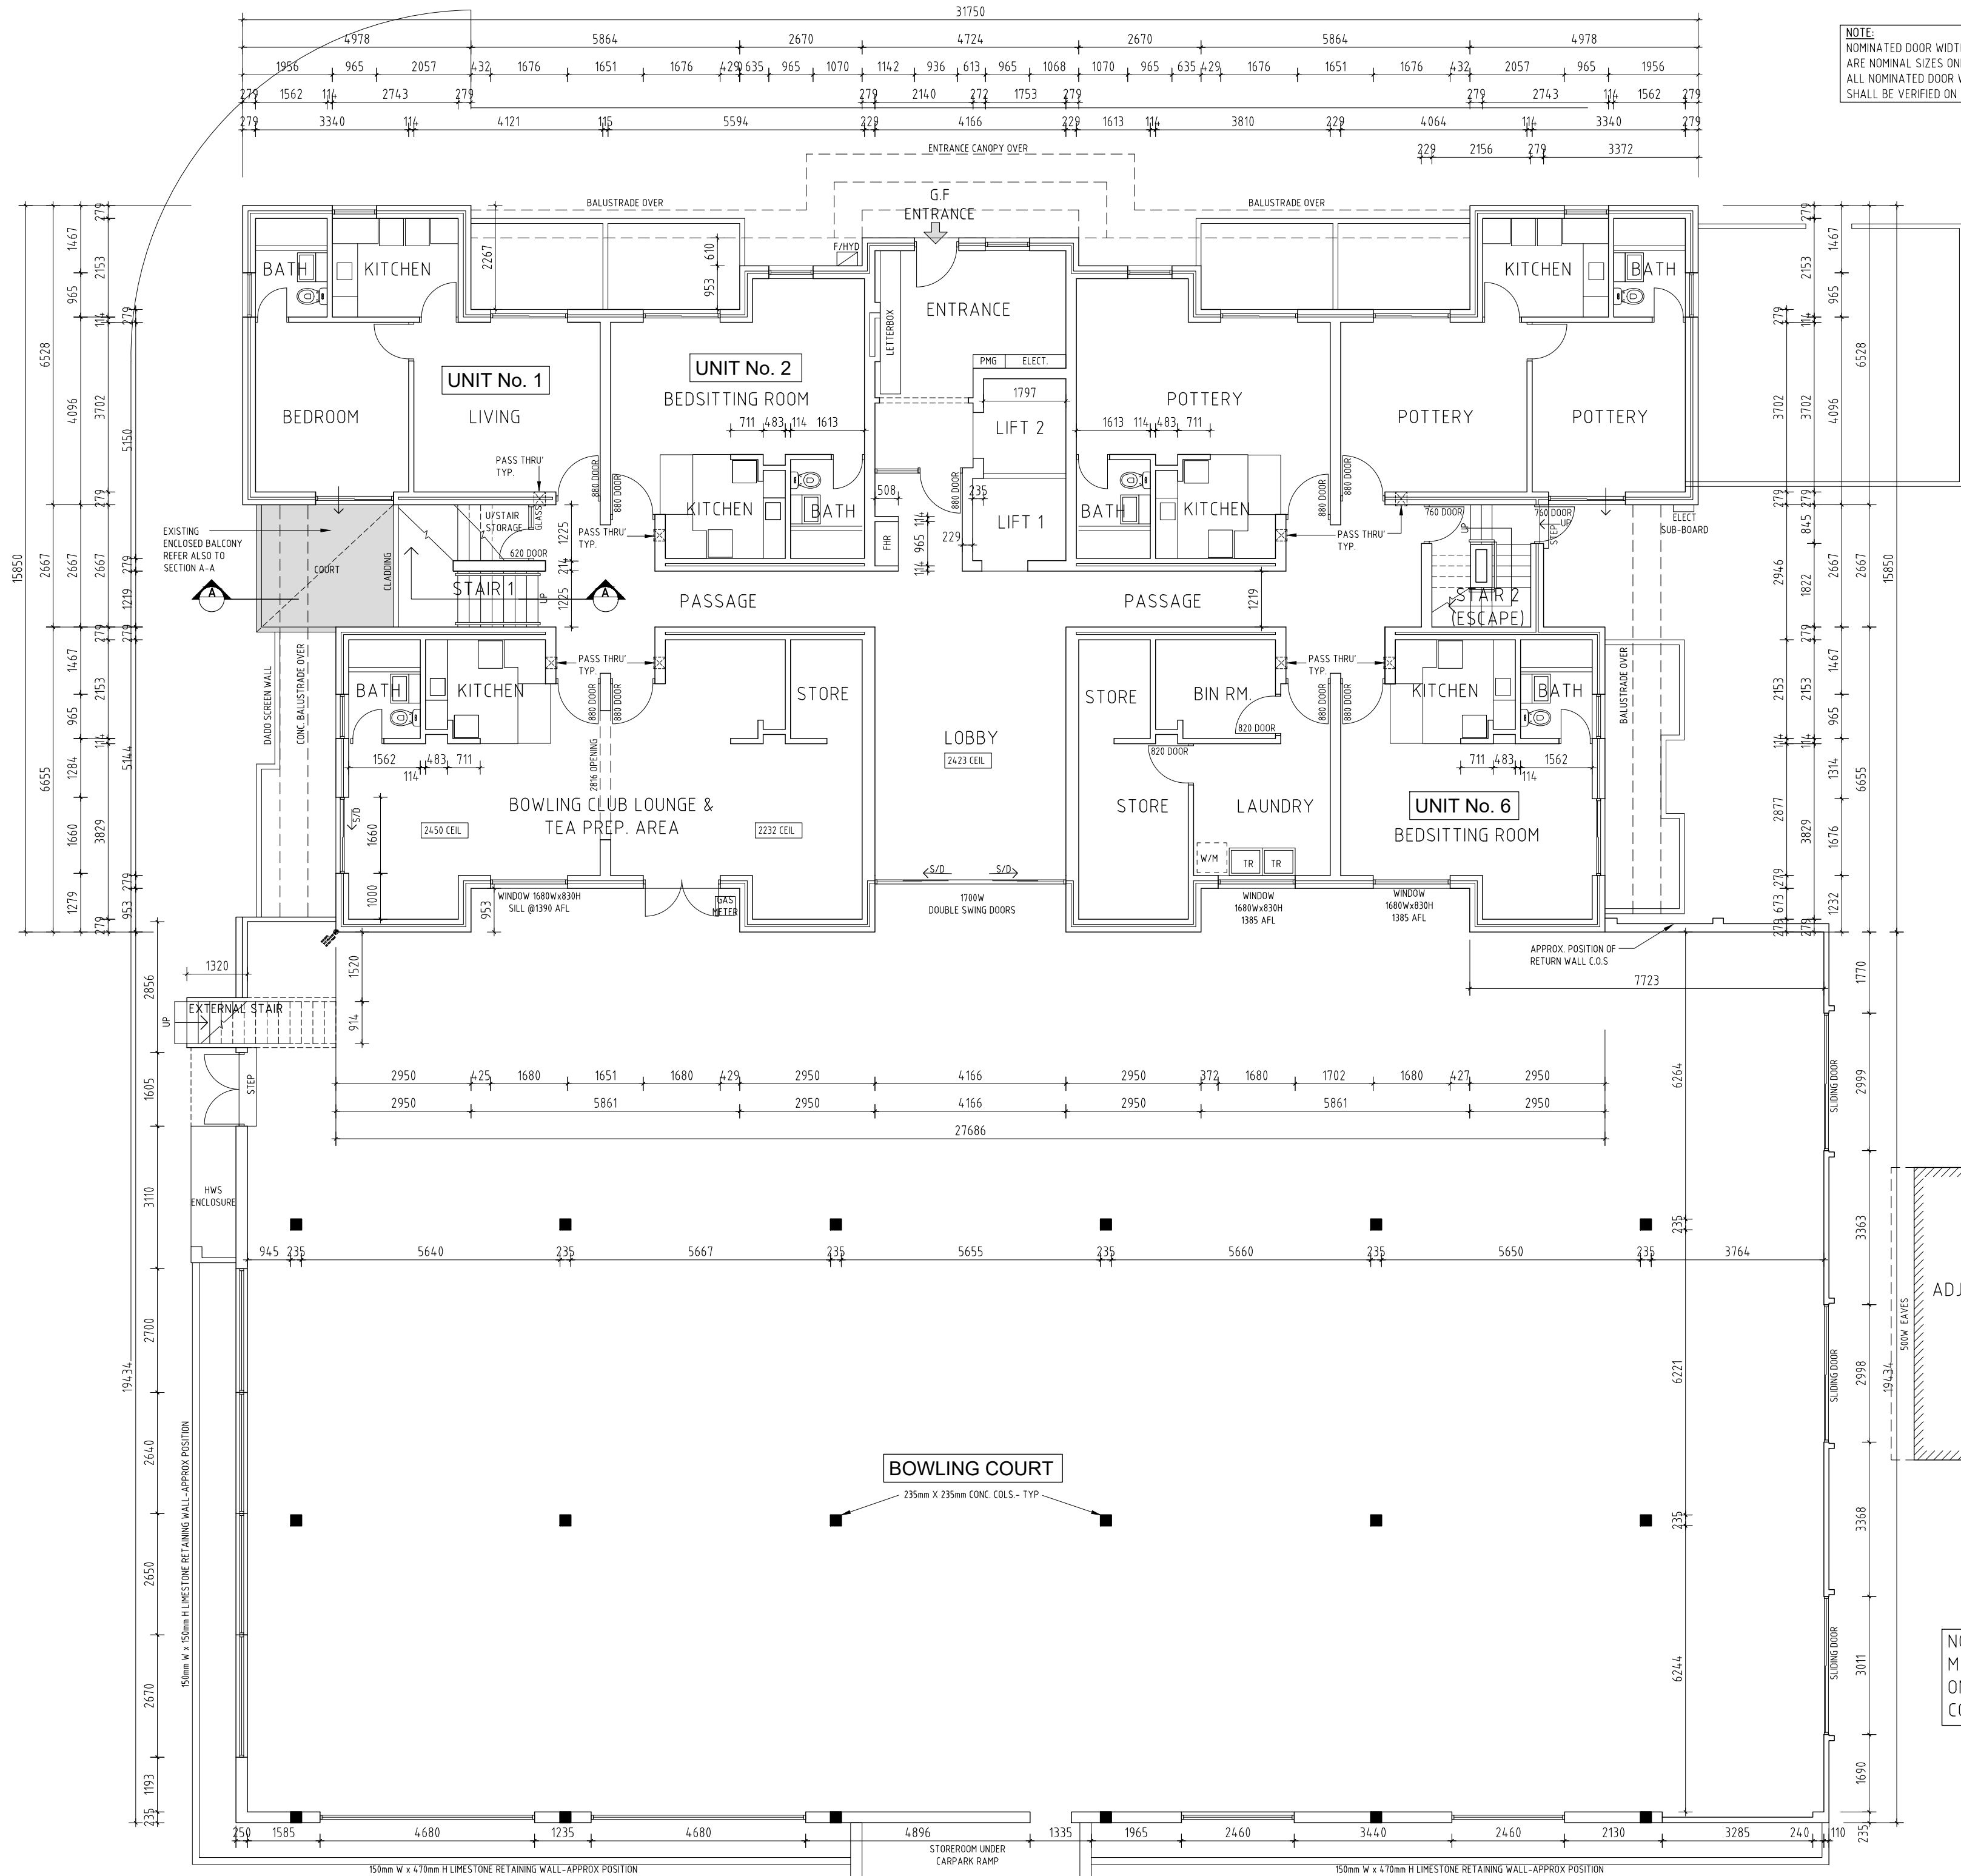


NOTE:
NOMINATED DOOR WIDTH SHOWN ON PLAN
ARE NOMINAL SIZES ONLY.
ALL NOMINATED DOOR WIDTHS & MATERIALS
SHALL BE VERIFIED ON SITE.

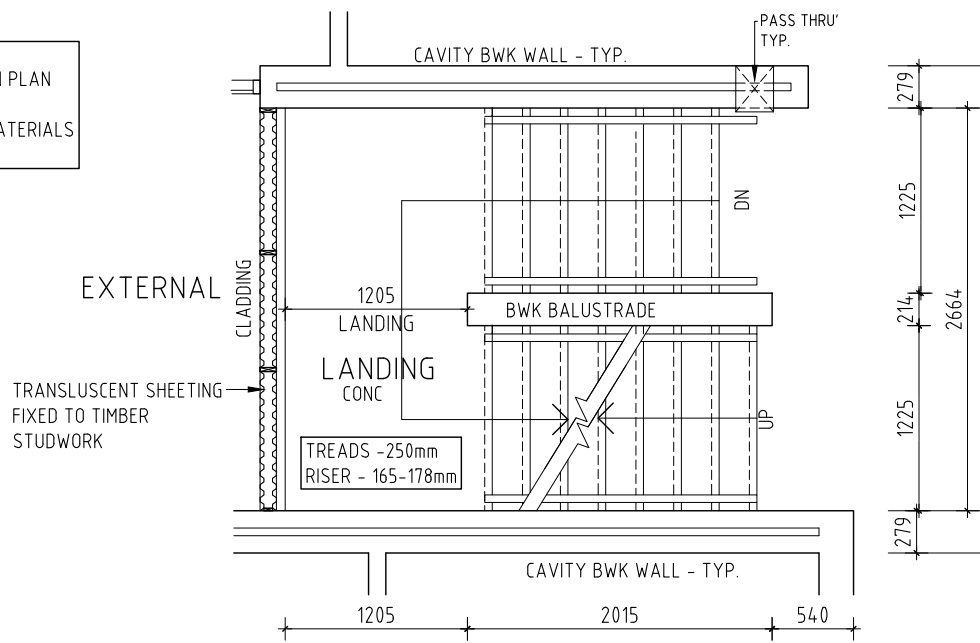

Stair 1 - Plan (Main Stairs) Typical Floor Existing

scale 1:50

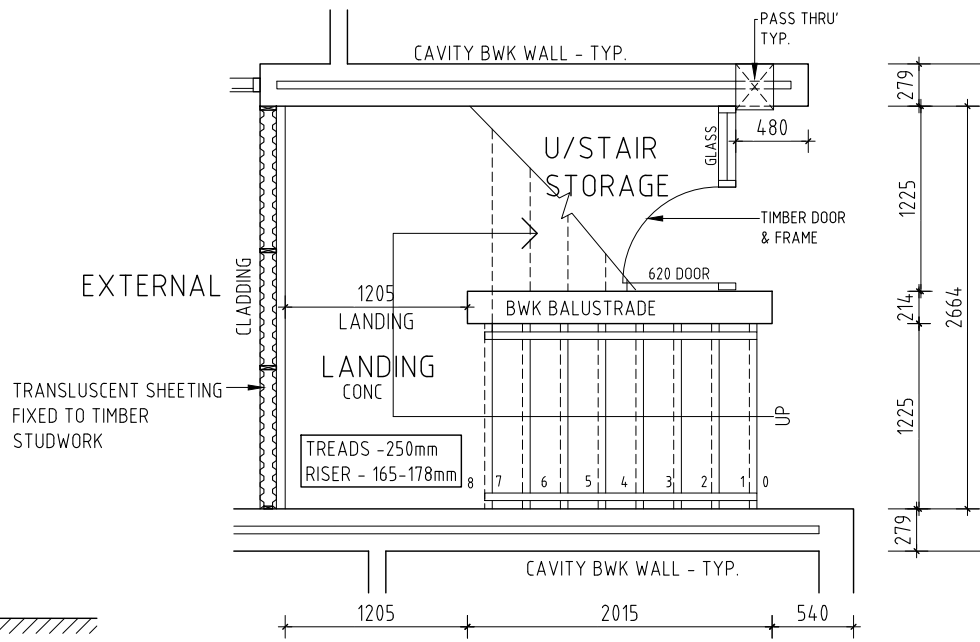


Stair 1 - Plan (Main Stairs) Ground Floor Existing

scale 1:50

LANDINGS: INSITU REINF. CONC. GRAND. FINISH	
TREADS: (OPEN RISERS) 317mm WIDE x 76mm THICK PRECAST REINF. CONC. EXPOSED AGGREGATE FINISH	HANDRAILS 95mm x 30mm TIMBER MATT FINISH FIXED TO 38Ø PIPE SPACER BOLTED TO MASONRY WALL

Ground Floor Plan / Bowling Court

scale 1:100

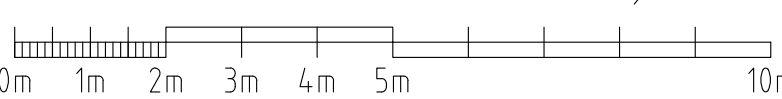

PRELIMINARY DRAWING
NOT FOR CONSTRUCTION

AS CONSTRUCTED
AS AT 22.02.2024

NOTE:
THESE ARE CAD CONVERSION DRAWINGS
FROM IMPERIAL AND ARE
NOT TO BE USED FOR
CONSTRUCTION PURPOSES

NOTE:
MEASURE & CHECK ALL DIMENSIONS
ON SITE TO CONFIRM LAYOUT PRIOR TO
CONSTRUCTION

VISTA DESIGNS
Building Designers



SUITE 3, 279 LORD STREET
EAST PERTH 6004
TEL / FAX: 92277415
© COPYRIGHT

SWAN CARE RICHARD CLEAVER LODGE
34 Graham Cres,
BENTLEY WA 6102

Drawing Title
Ground Floor / Bowling Court Plan
Existing Floor Plan

Drawn	Scale 1:50, 1:100, 1:200	Date 25.03.24	Job No. 3097	Drawing No.	Rev
				A3	A

Check all dimensions on site prior to commencement of any works.
Unauthorized copying or distribution of this drawing is strictly
prohibited. Copyright © 2023

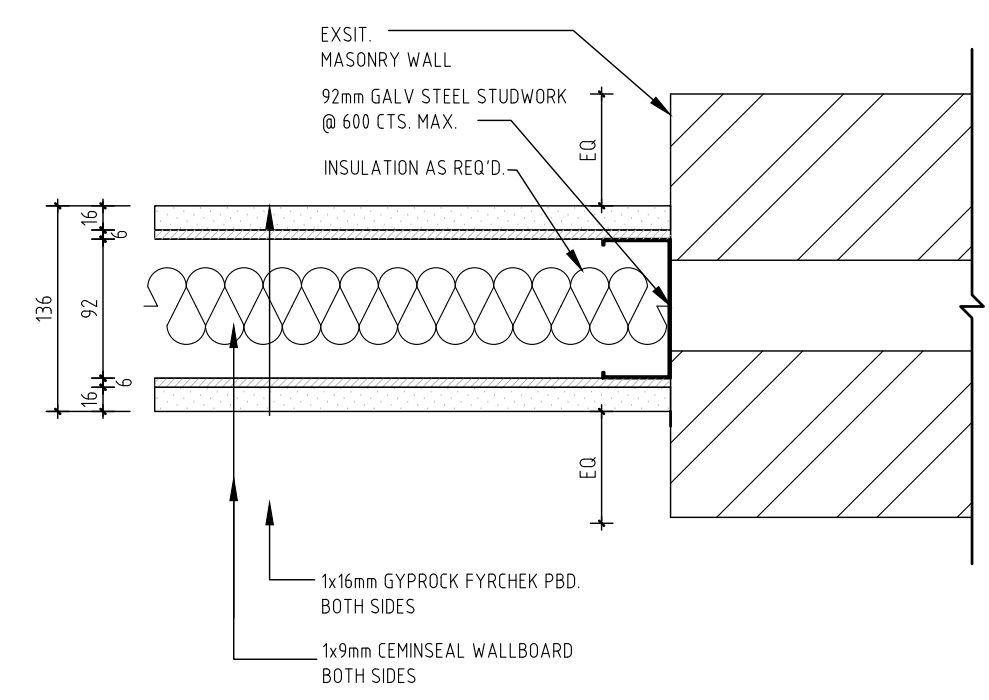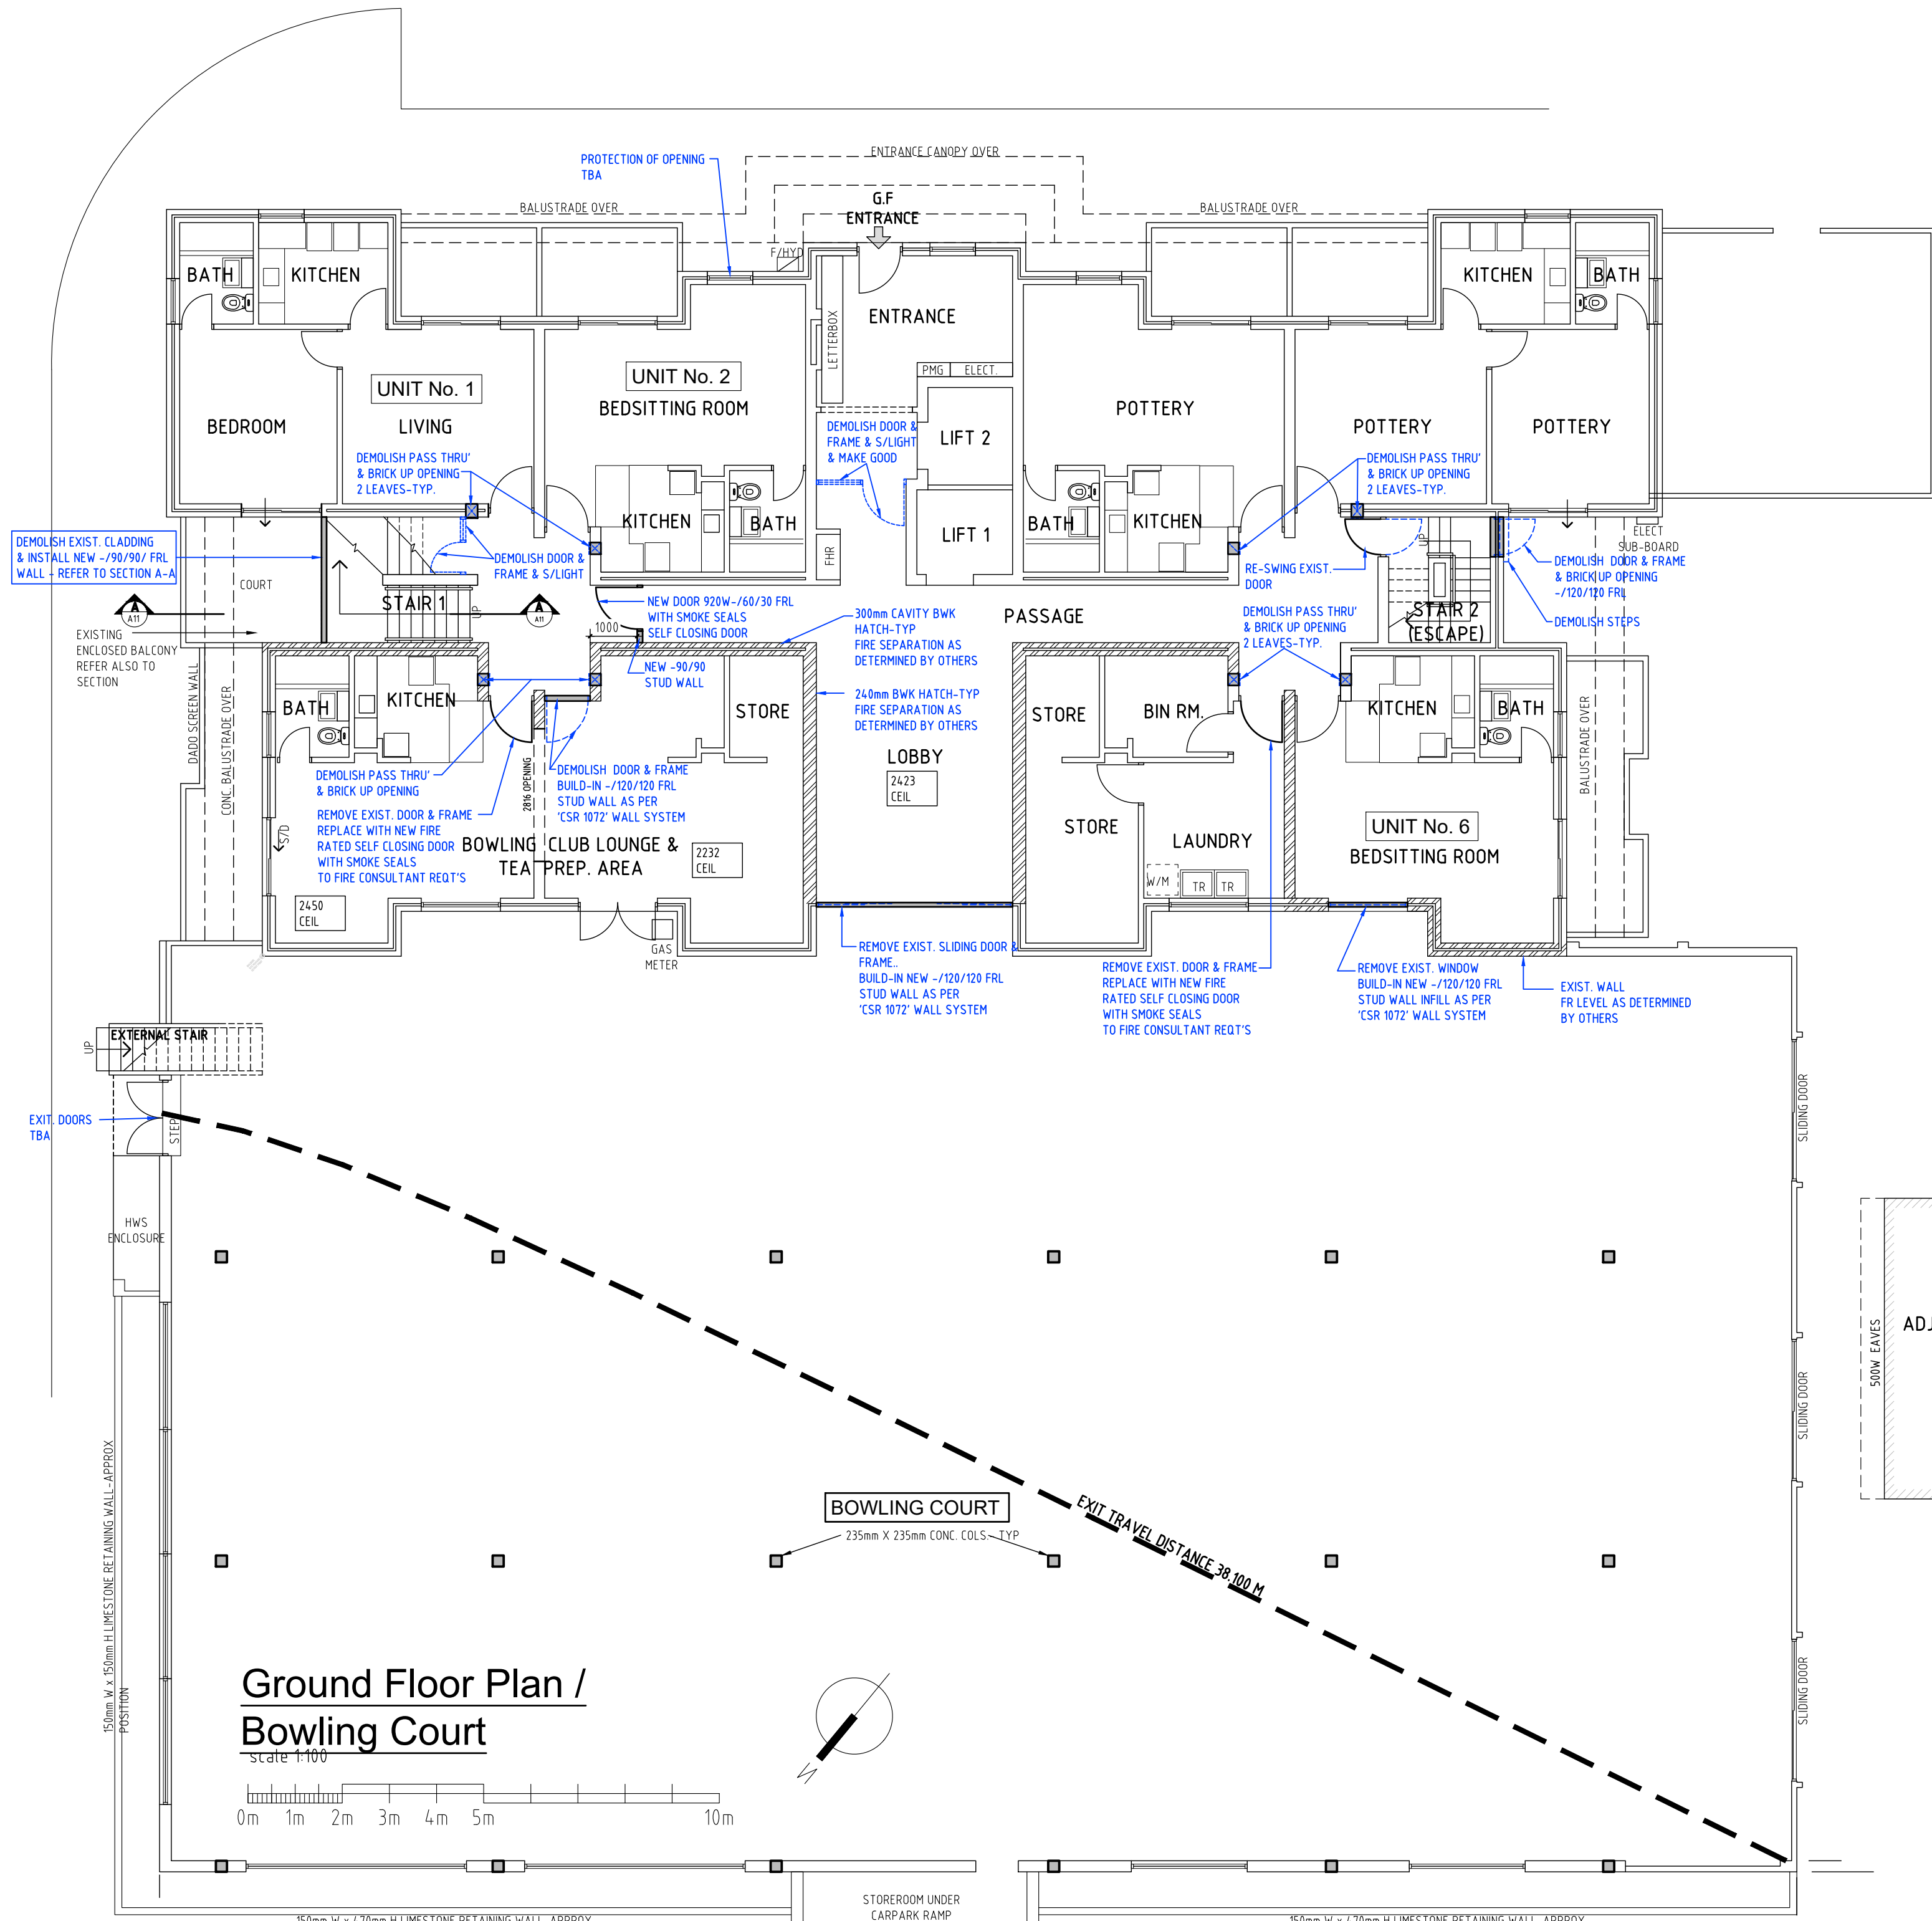

NOTE:
MEASURE & CHECK ALL DIMENSIONS
ON SITE TO CONFIRM LAYOUT PRIOR TO
CONSTRUCTION

GENERAL NOTES

- PAINT TO ALL NEW WALLS & CEILINGS TO AS/NZS 2311:2017
- DO NOT SCALE DRAWING - DIMENSIONS TO GOVERN SCALE
- ALL DIMENSIONS ARE TO BE CHECKED ON SITE PRIOR TO THE COMMENCEMENT OF ANY WORK OR THE FABRICATION OF ANY ITEMS
- ALL MATERIALS ARE TO BE INSTALLED IN ACCORDANCE WITH THE 'NCC' & MANUFACTURER'S RECOMMENDATIONS UNLESS NOTED OTHERWISE
- EXTENT OF DEMOLITION NOT LIMITED TO AS STATED & MAKE GOOD TO ALL EXISTING ADJOINING FINISHES
- THIS DRAWING SHALL BE READ IN CONJUNCTION & COMPLY WITH THE FOLLOWING:
 - HVAC DRAWINGS BY OTHERS
 - ELECTRICAL DRAWINGS BY OTHERS
 - FIRE ENGINEER'S REPORTS
 - AS 14-28 CODE REQUIREMENTS
 - MANUFACTURER'S SPECIFICATIONS
 - 'NCC' REQUIREMENTS

PRELIMINARY DRAWING
NOT FOR CONSTRUCTION


NOTE:
THESE ARE CAD CONVERSION DRAWINGS
FROM IMPERIAL AND ARE
NOT TO BE USED FOR
CONSTRUCTION PURPOSES

REV	DESCRIPTION	DATE
A	PRELIMINARY ISSUE	26.03.2024

VISTA DESIGNS
Building Designers
SUITE 3, 279 LORD STREET
EAST PERTH 6004
TEL./FAX: 92277415
© COPYRIGHT



SWAN CARE RICHARD CLEAVER LODGE
34 Graham Cres,
BENTLEY WA 6102
Drawing Title
Ground Floor Plan / Bowling Court
Demolition / Proposed Upgrade
Drawn
Scale
1:500
Date
26.03.24
Job No.
3097
Drawing No.
A4
Rev
A

BENTLEY DEMOLITION PROPOSED GROUND FLOOR ALDING 956 AM 27.03.2024

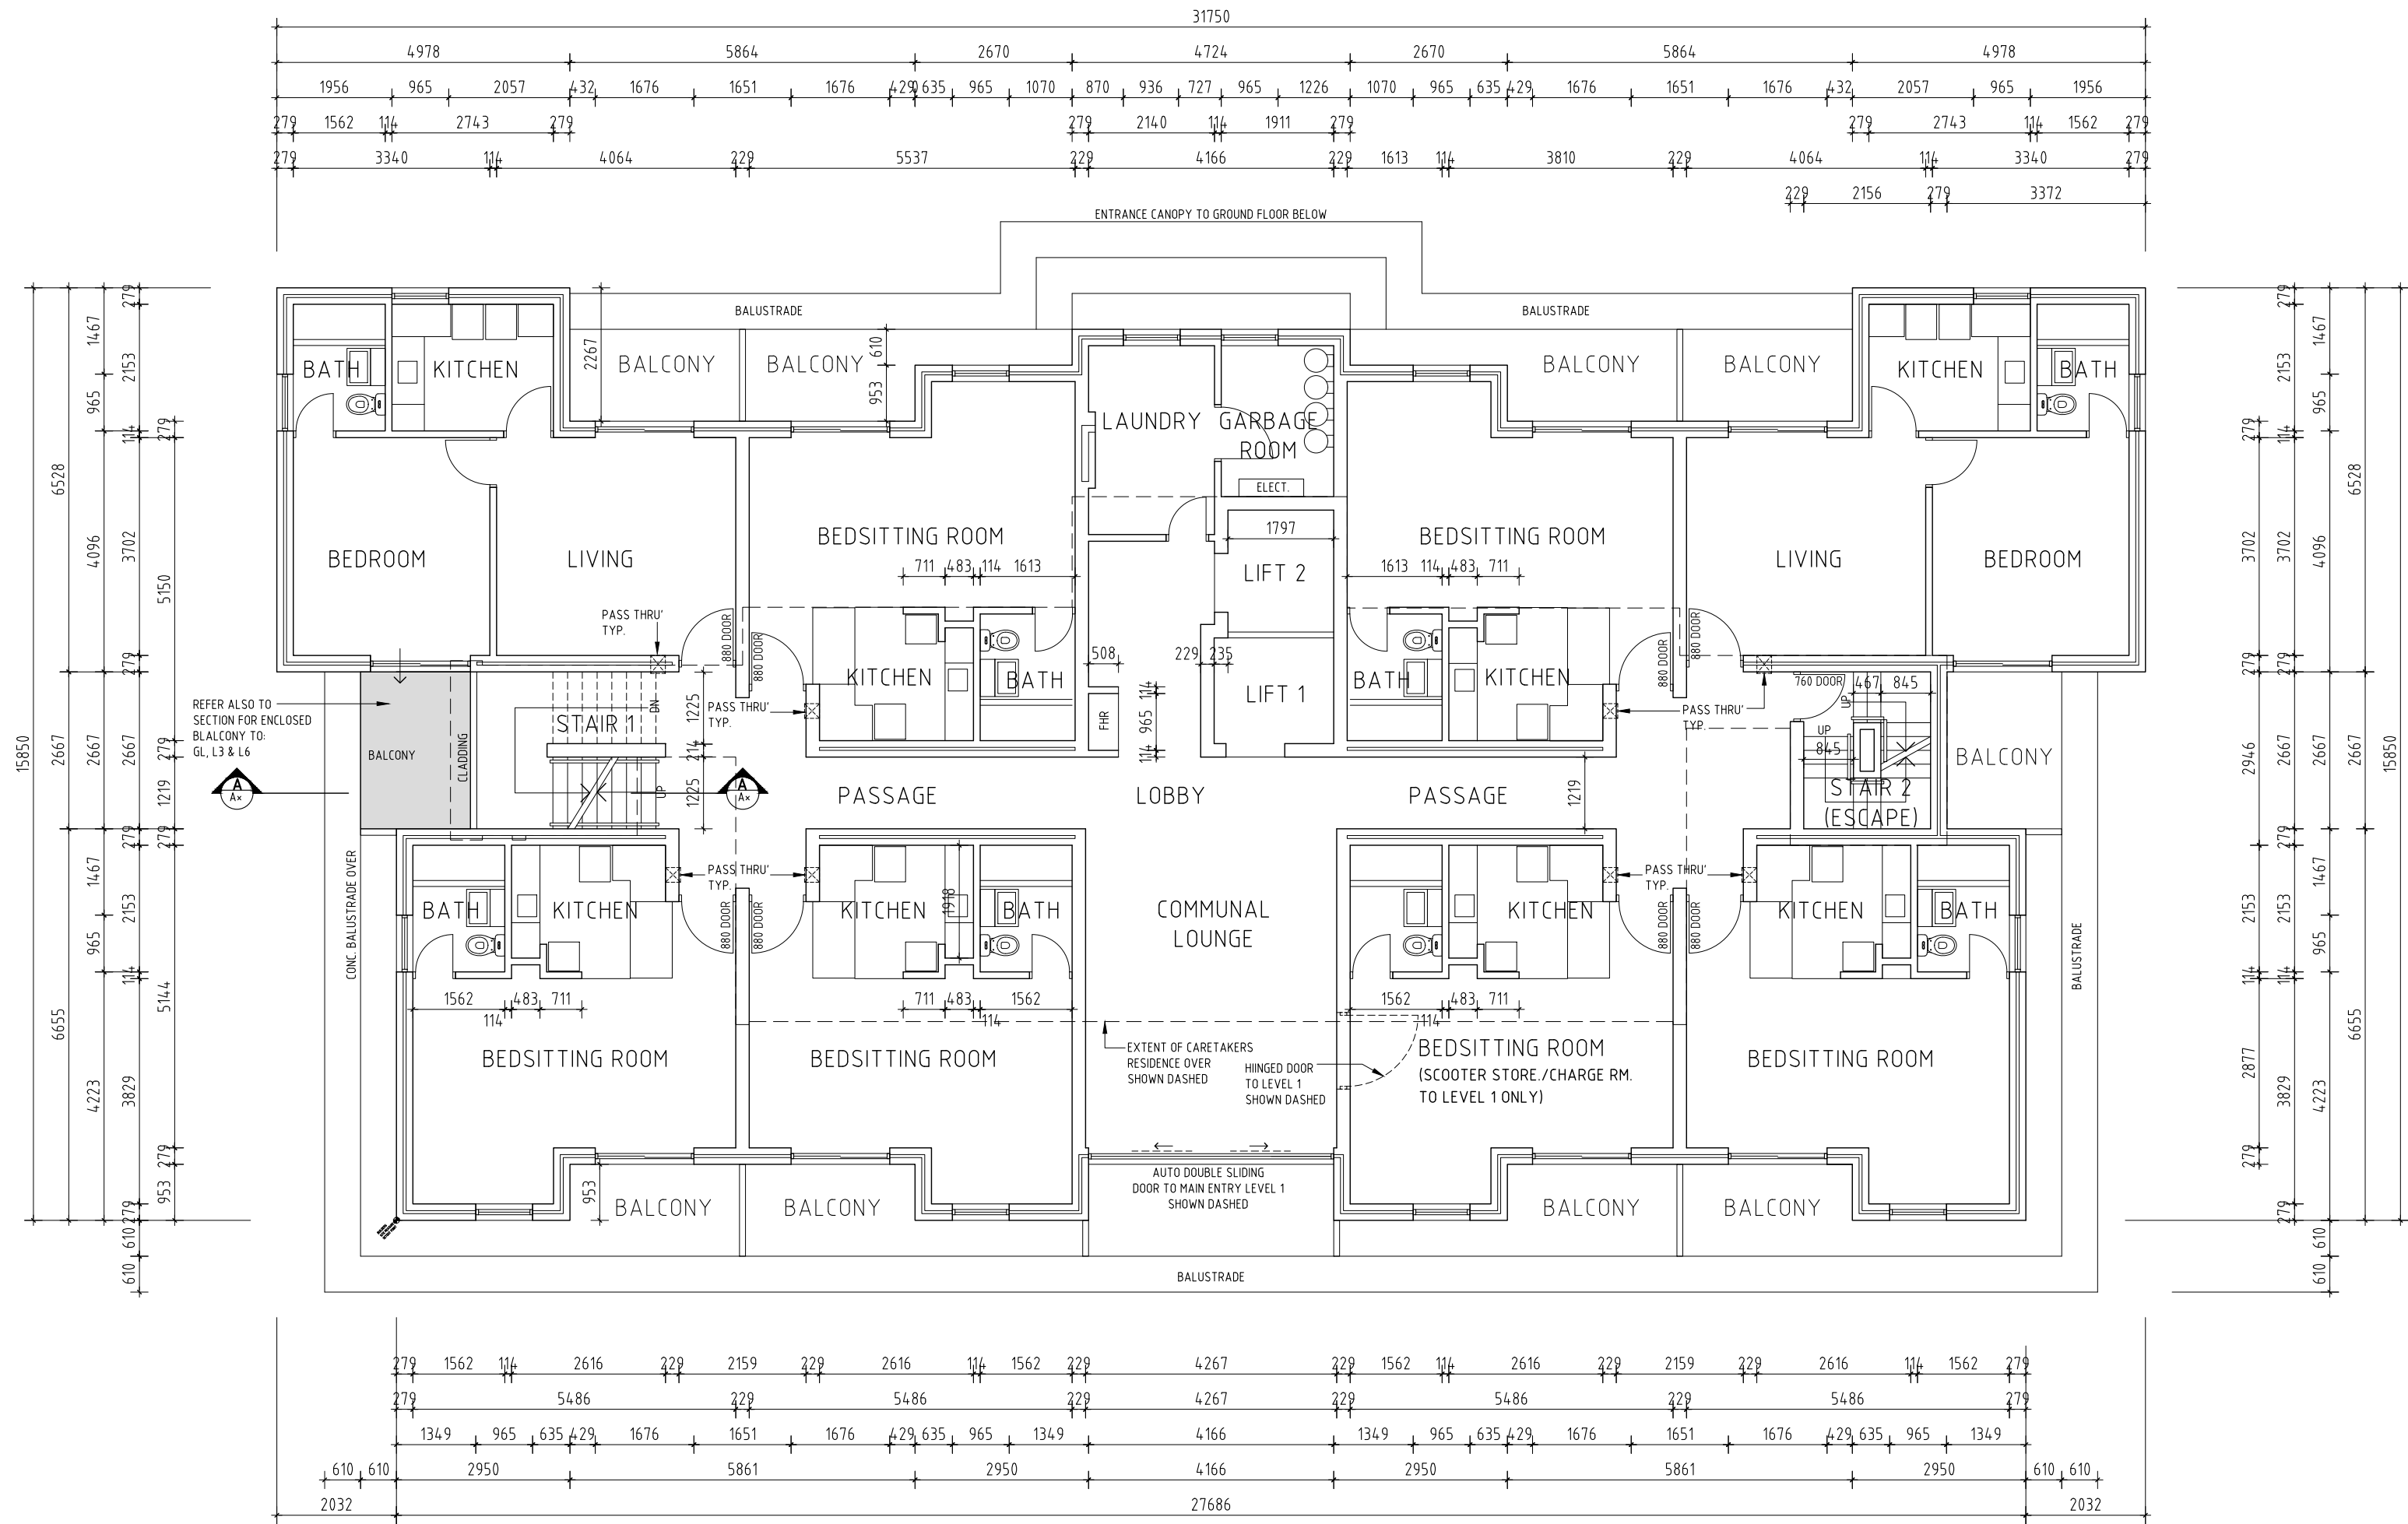

Typical Floor Plan Level 2 - Level 6

scale 1:100

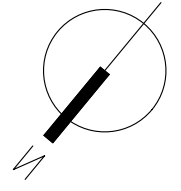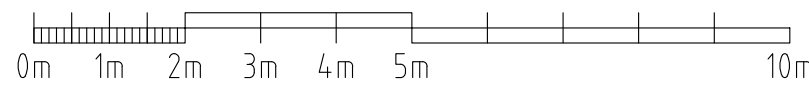

NOTE:
NOMINATED DOOR WIDTH SHOWN ON PLAN
ARE NOMINAL SIZES ONLY.
ALL NOMINATED DOOR WIDTHS & MATERIALS
SHALL BE VERIFIED ON SITE.

PRELIMINARY DRAWING
NOT FOR CONSTRUCTION

AS CONSTRUCTED
AS AT 22.02.2024

NOTE:
THESE ARE CAD CONVERSION DRAWINGS
FROM IMPERIAL AND ARE
NOT TO BE USED FOR
CONSTRUCTION PURPOSES

A	PRELIMINARY ISSUE	25.03.2024
REV	DESCRIPTION	DATE

VISTA DESIGNS
Building Designers


SUITE 3, 279 LORD STREET
EAST PERTH 6004
TEL / FAX: 92277415
© COPYRIGHT

SWAN CARE RICHARD CLEAVER LODGE
34 Graham Cres,
BENTLEY WA 6102

Drawing Title
Typical Floor Plan - Level 2 - Level 6
Existing Floor Plan




Drawn	Scale 1:100@A2	Date 25.03.24	Job No. 3097	Drawing No.	Rev
				A5	A

Check all dimensions on site prior to commencement of any works
Unauthorized copying or distribution of this drawing is strictly
prohibited. Copyright © 2023

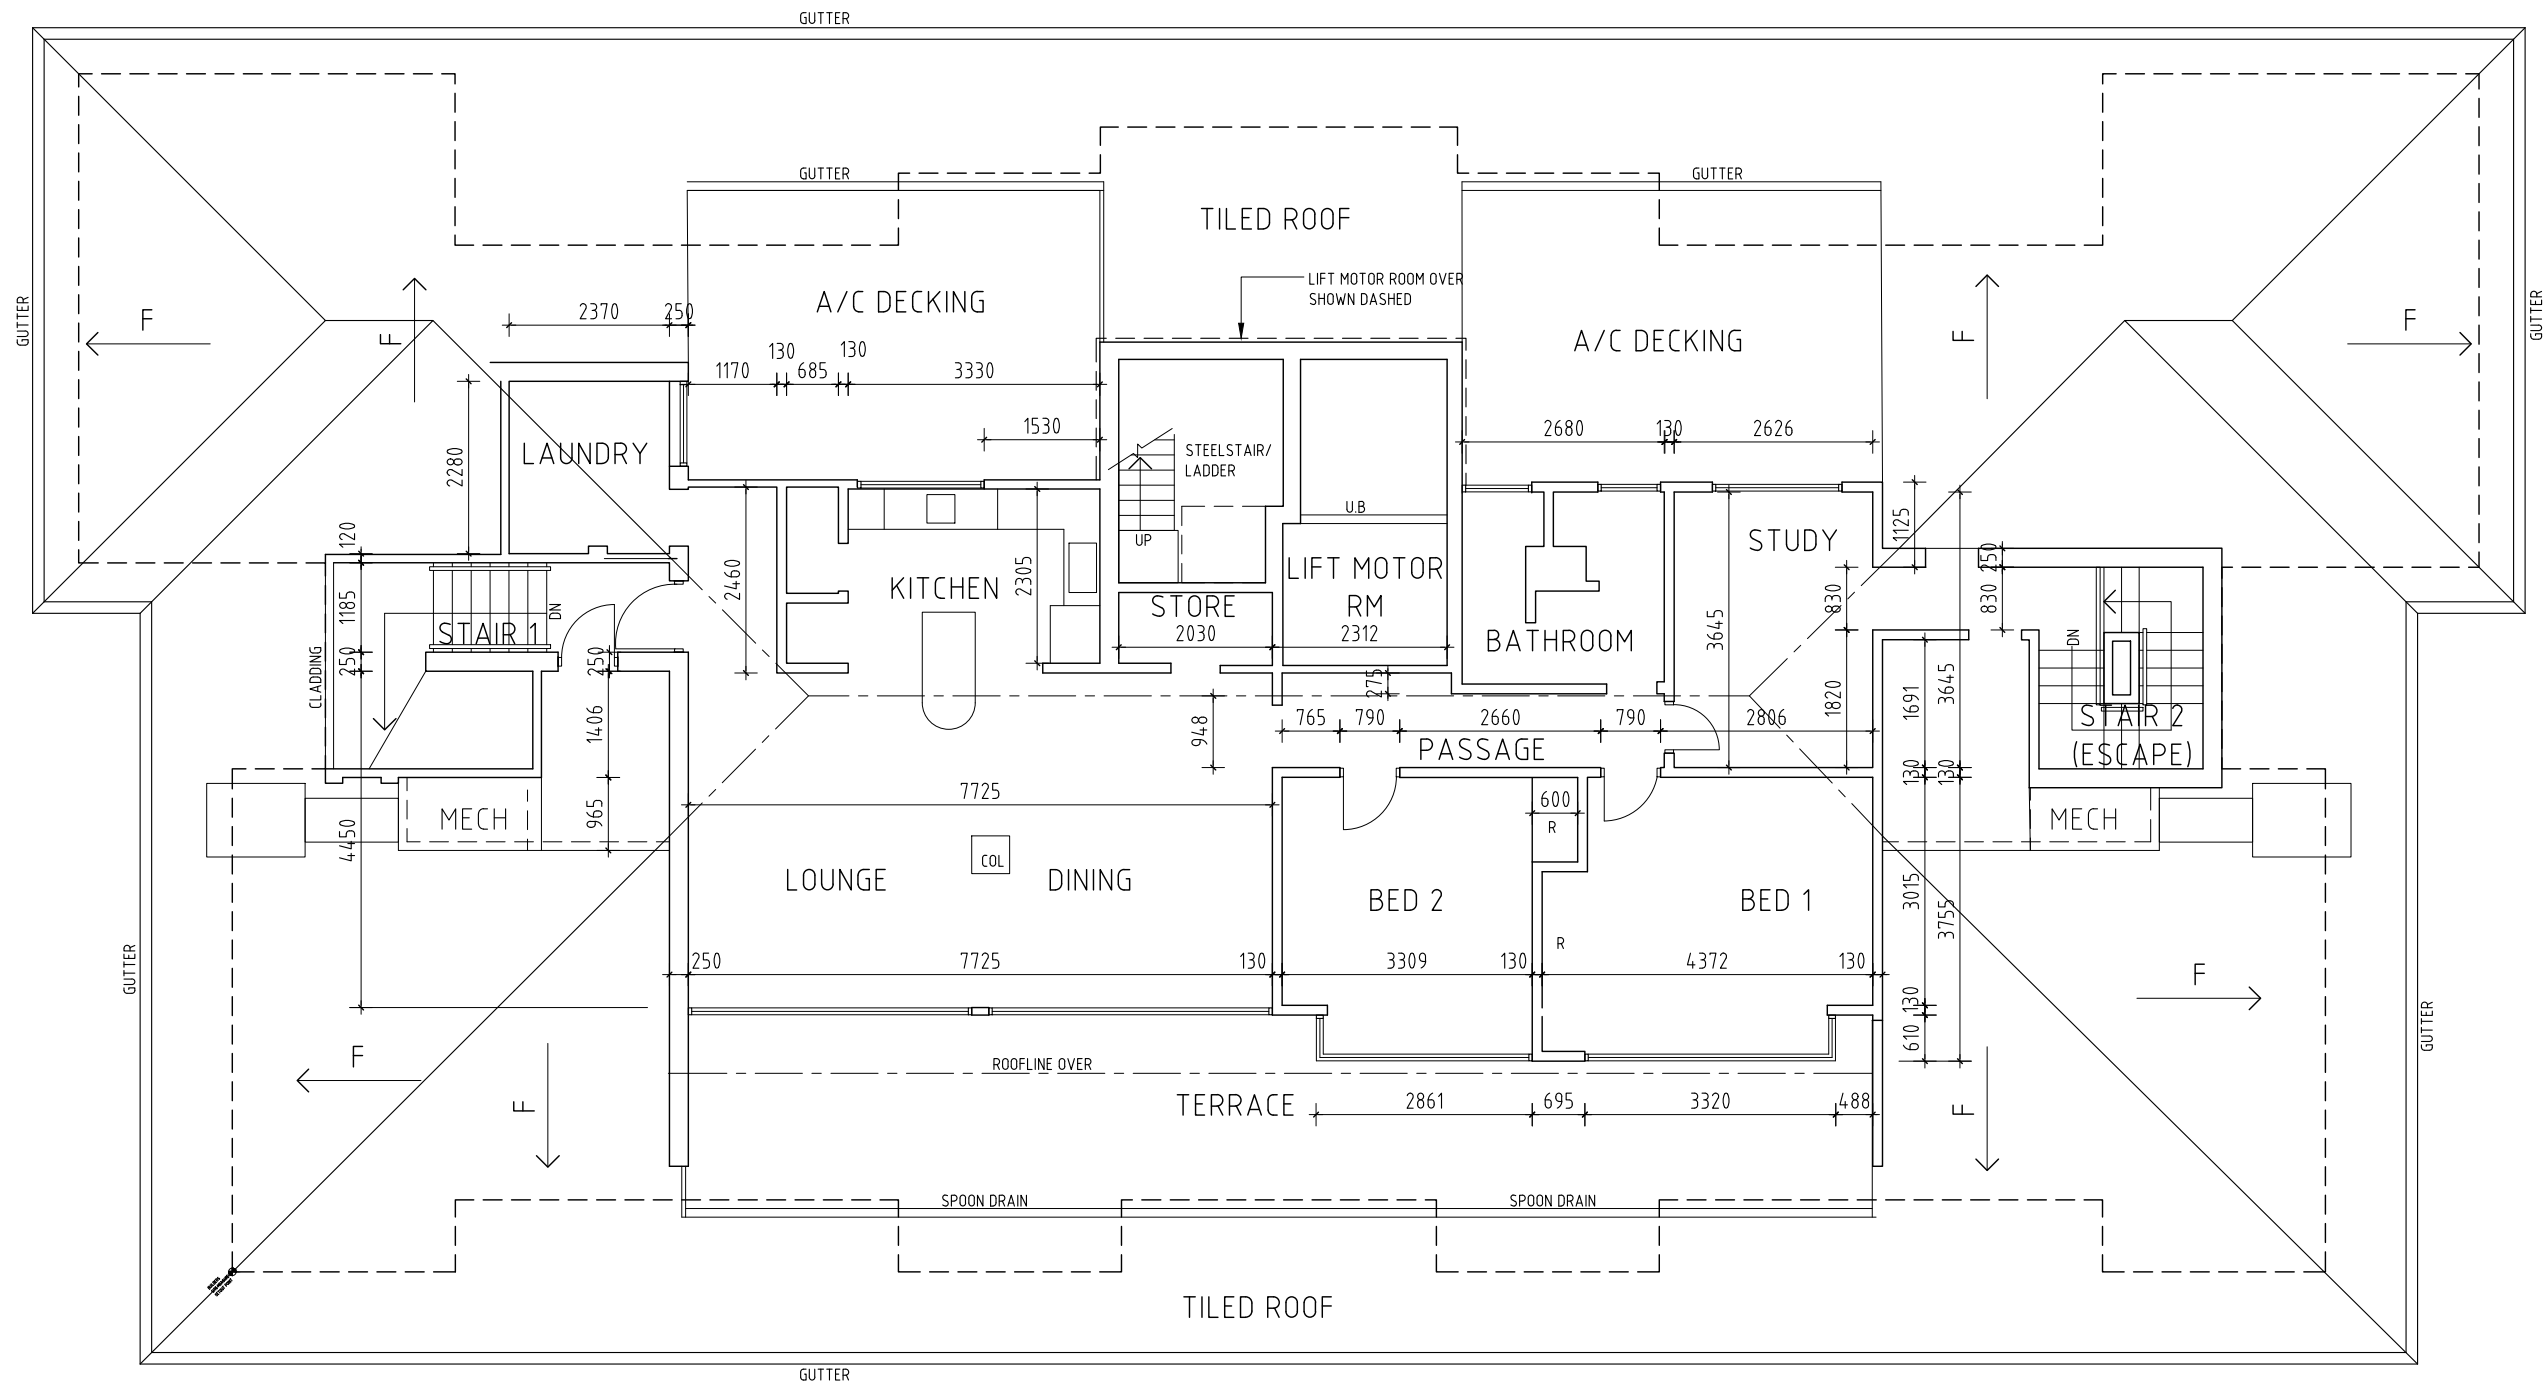

Caretakers Residence - Existing Floor Plan

scale 1:100

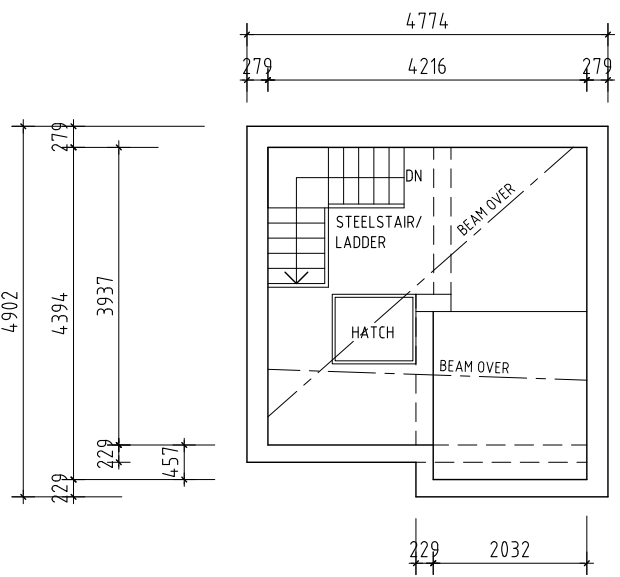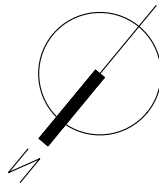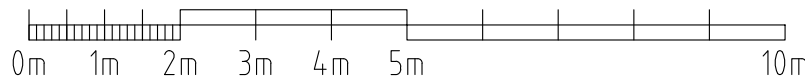

Lift Motor Room
Floor plan

scale 1:100

PRELIMINARY DRAWING
NOT FOR CONSTRUCTION

AS CONSTRUCTED
AS AT 22.02.2024

NOTE:
THESE ARE CAD CONVERSION DRAWINGS
FROM IMPERIAL AND ARE
NOT TO BE USED FOR
CONSTRUCTION PURPOSES

A	PRELIMINARY ISSUE	25.03.2024
REV	DESCRIPTION	DATE

VISTA DESIGNS
Building Designers


SUITE 3, 279 LORD STREET
EAST PERTH 6004
TEL./FAX: 92277415
© COPYRIGHT

SWAN CARE RICHARD CLEAVER LODGE
34 Graham Cres,
BENTLEY WA 6102

Drawing Title
Caretakers Residence
Existing Floor plan

Drawn	Scale 1:100@A2	Date 25.03.24	Job No. 3097	Drawing No.	Rev
Check all dimensions on site prior to commencement of any works Unauthorized copying or distribution of this drawing is strictly prohibited. Copyright © 2023				A7	A




NOTE:
MEASURE & CHECK ALL DIMENSIONS
ON SITE TO CONFIRM LAYOUT PRIOR TO
CONSTRUCTION

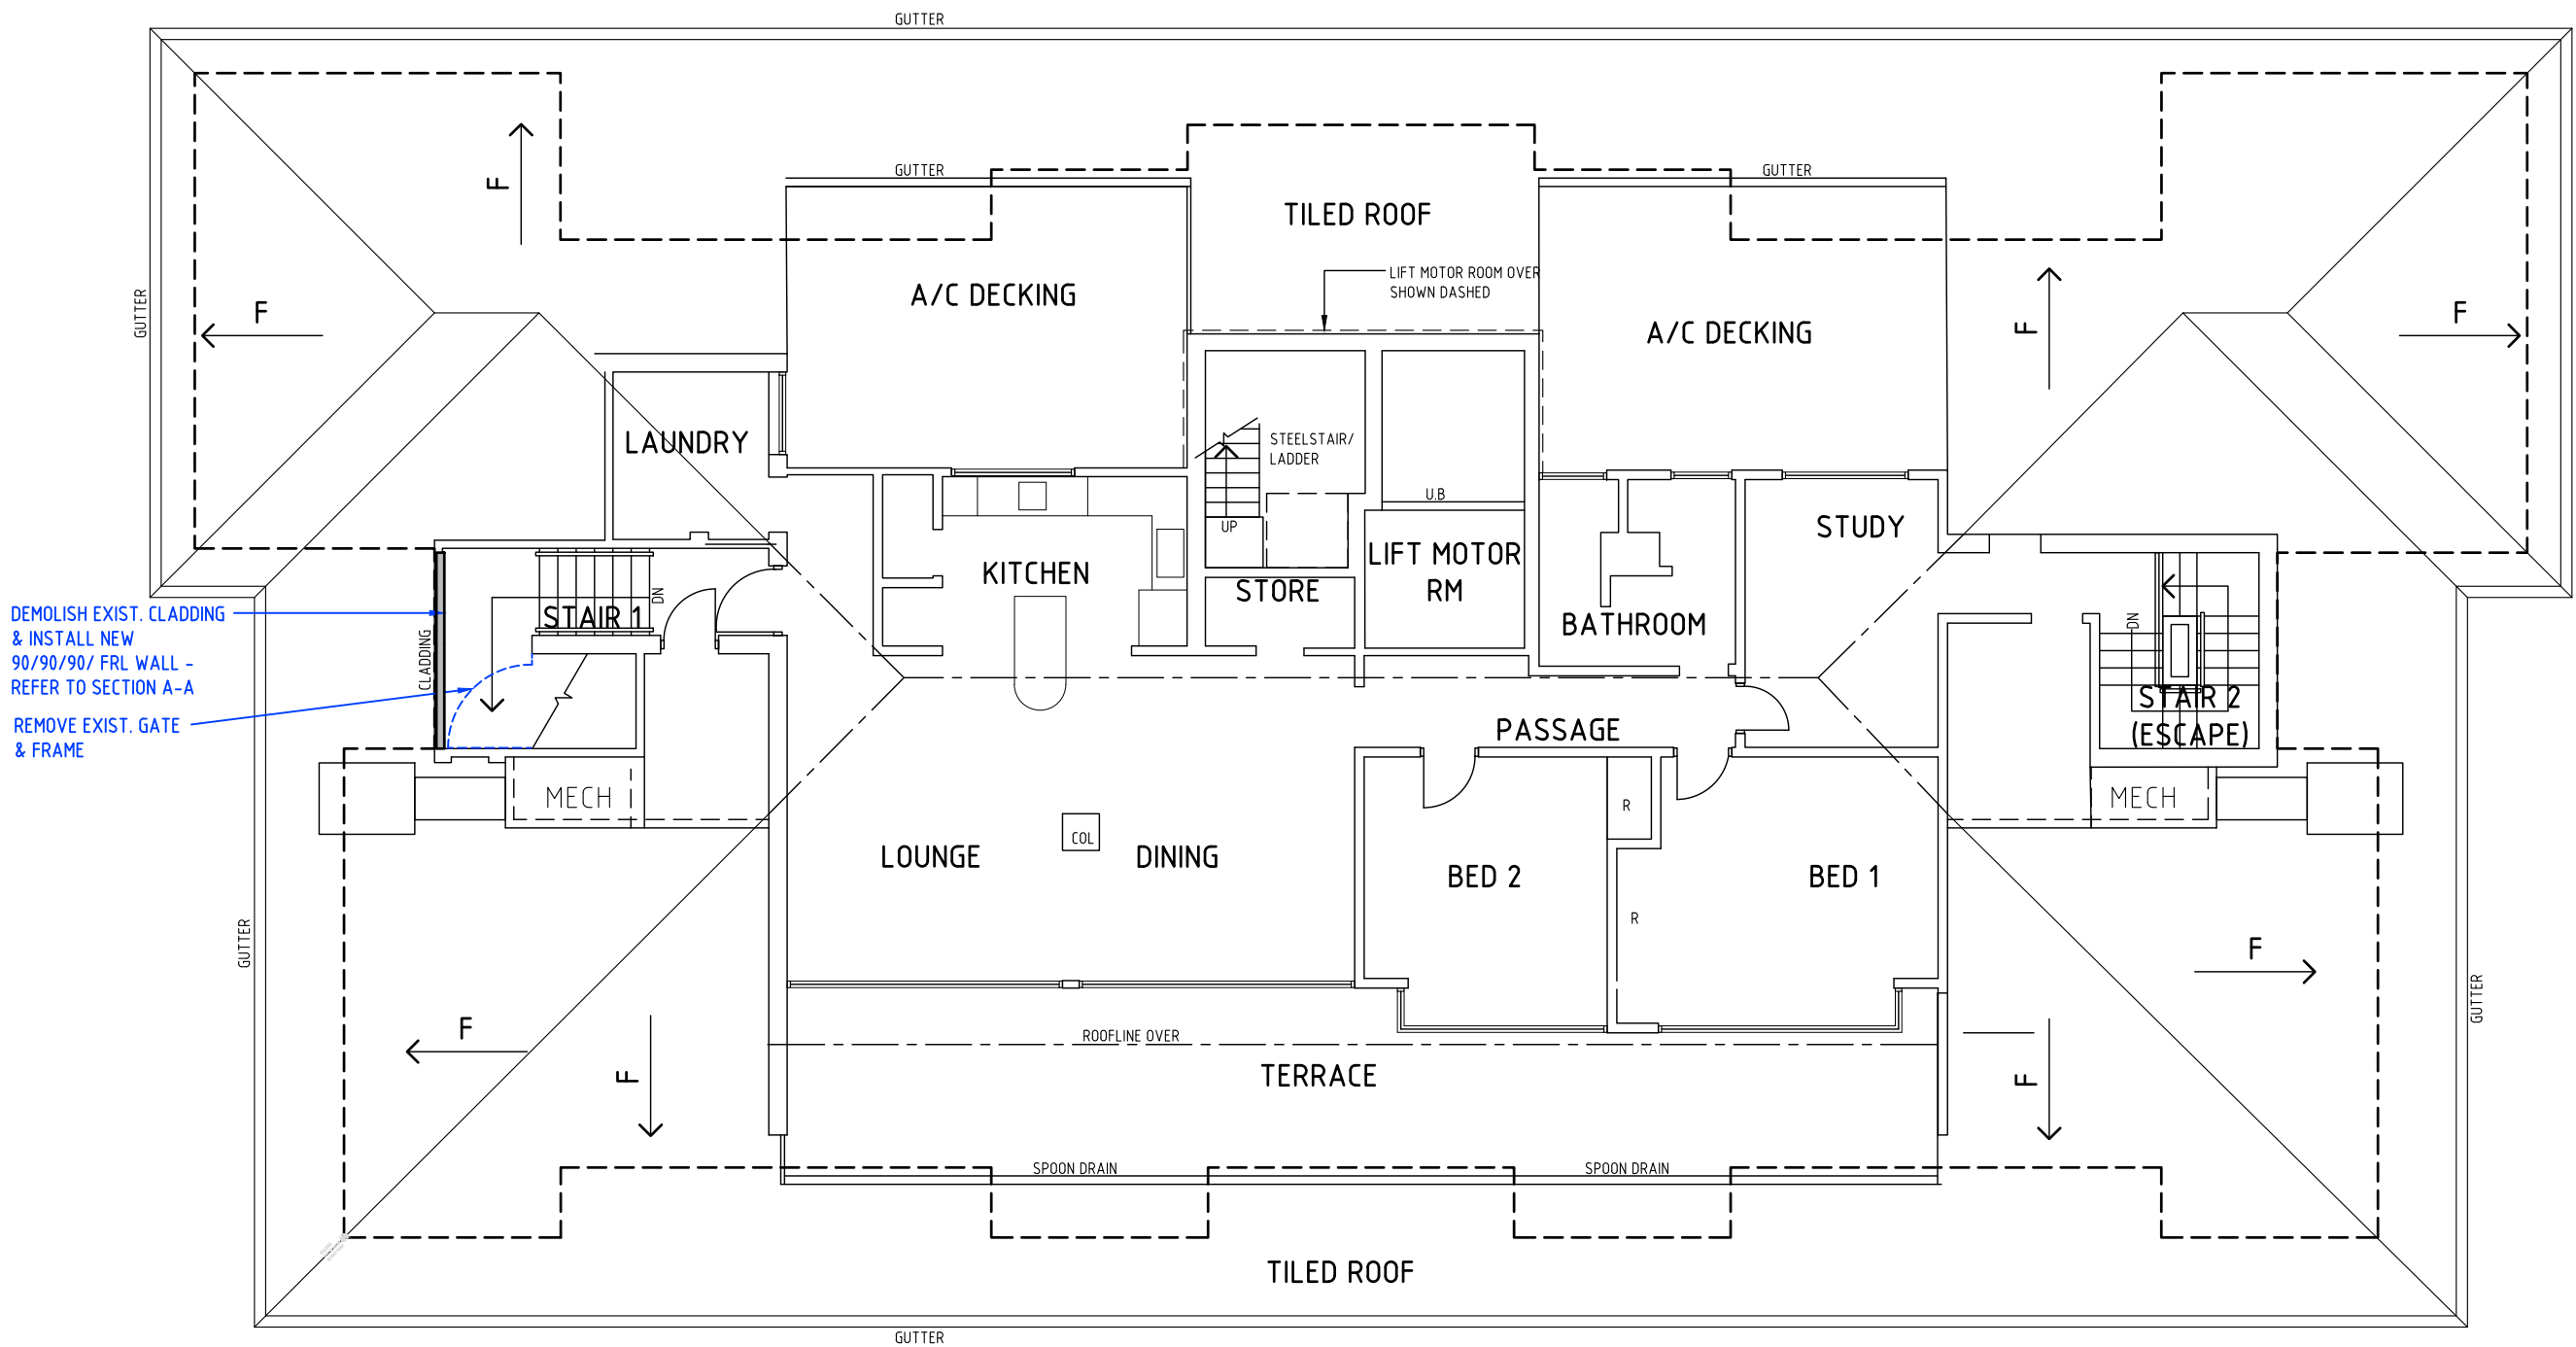

DEMOLISH EXIST. CLADDING
& INSTALL NEW
90/90/90/ FRL WALL -
REFER TO SECTION A-A
REMOVE EXIST. GATE
& FRAME

Caretakers Residence - Floor Plan Demolition / Proposed Upgrade

scale 1:100

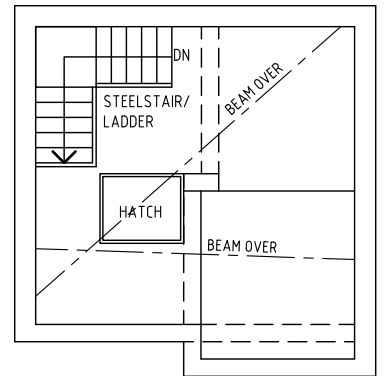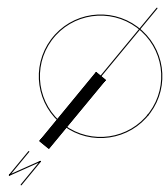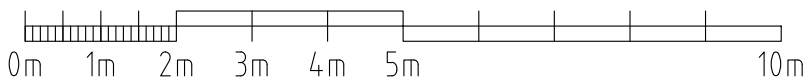

Lift Motor Room Floor plan

scale 1:100

GENERAL NOTES

- PAINT TO ALL NEW WALLS & CEILINGS TO AS/NZS 2311:2017
- DO NOT SCALE DRAWING - DIMENSIONS TO GOVERN SCALE
- ALL DIMENSIONS ARE TO BE CHECKED ON SITE PRIOR TO THE COMMENCEMENT OF ANY WORK OR THE FABRICATION OF ANY ITEMS
- ALL MATERIALS ARE TO BE INSTALLED IN ACCORDANCE WITH THE 'NCC' & MANUFACTURER'S RECOMMENDATIONS UNLESS NOTED OTHERWISE
- EXTENT OF DEMOLITION NOT LIMITED TO AS STATED & MAKE GOOD TO ALL EXISTING ADJOINING FINISHES
- THIS DRAWING SHALL BE READ IN CONJUNCTION & COMPLY WITH THE FOLLOWING:
 - HVAC DRAWINGS BY OTHERS
 - ELECTRICAL DRAWINGS BY OTHERS
 - FIRE ENGINEER'S REPORTS
 - AS 1428 CODE REQUIREMENTS
 - MANUFACTURER'S SPECIFICATIONS
 - 'NCC' REQUIREMENTS

PRELIMINARY DRAWING
NOT FOR CONSTRUCTION

NOTE:
THESE ARE CAD CONVERSION DRAWINGS
FROM IMPERIAL AND ARE
NOT TO BE USED FOR
CONSTRUCTION PURPOSES

REV	DESCRIPTION	DATE
A	PRELIMINARY ISSUE	26.03.2024

VISTA DESIGNS
Building Designers

SUITE 3, 279 LORD STREET
EAST PERTH 6004
TEL./FAX: 92277415
© COPYRIGHT


SWAN CARE RICHARD CLEAVER LODGE
34 Graham Cres,
BENTLEY WA 6102

Drawing Title
Caretakers Residence
Demolition / Proposed Upgrade

Drawn	Scale	Date	Job No.	Drawing No.	Rev
	1:100@A2	26.03.24	3097	A8	A

Check all dimensions on site prior to commencement of any works
Unauthorized copying or distribution of this drawing is strictly
prohibited. Copyright © 2023

NOTE:
MEASURE & CHECK ALL DIMENSIONS
ON SITE TO CONFIRM LAYOUT PRIOR TO
CONSTRUCTION

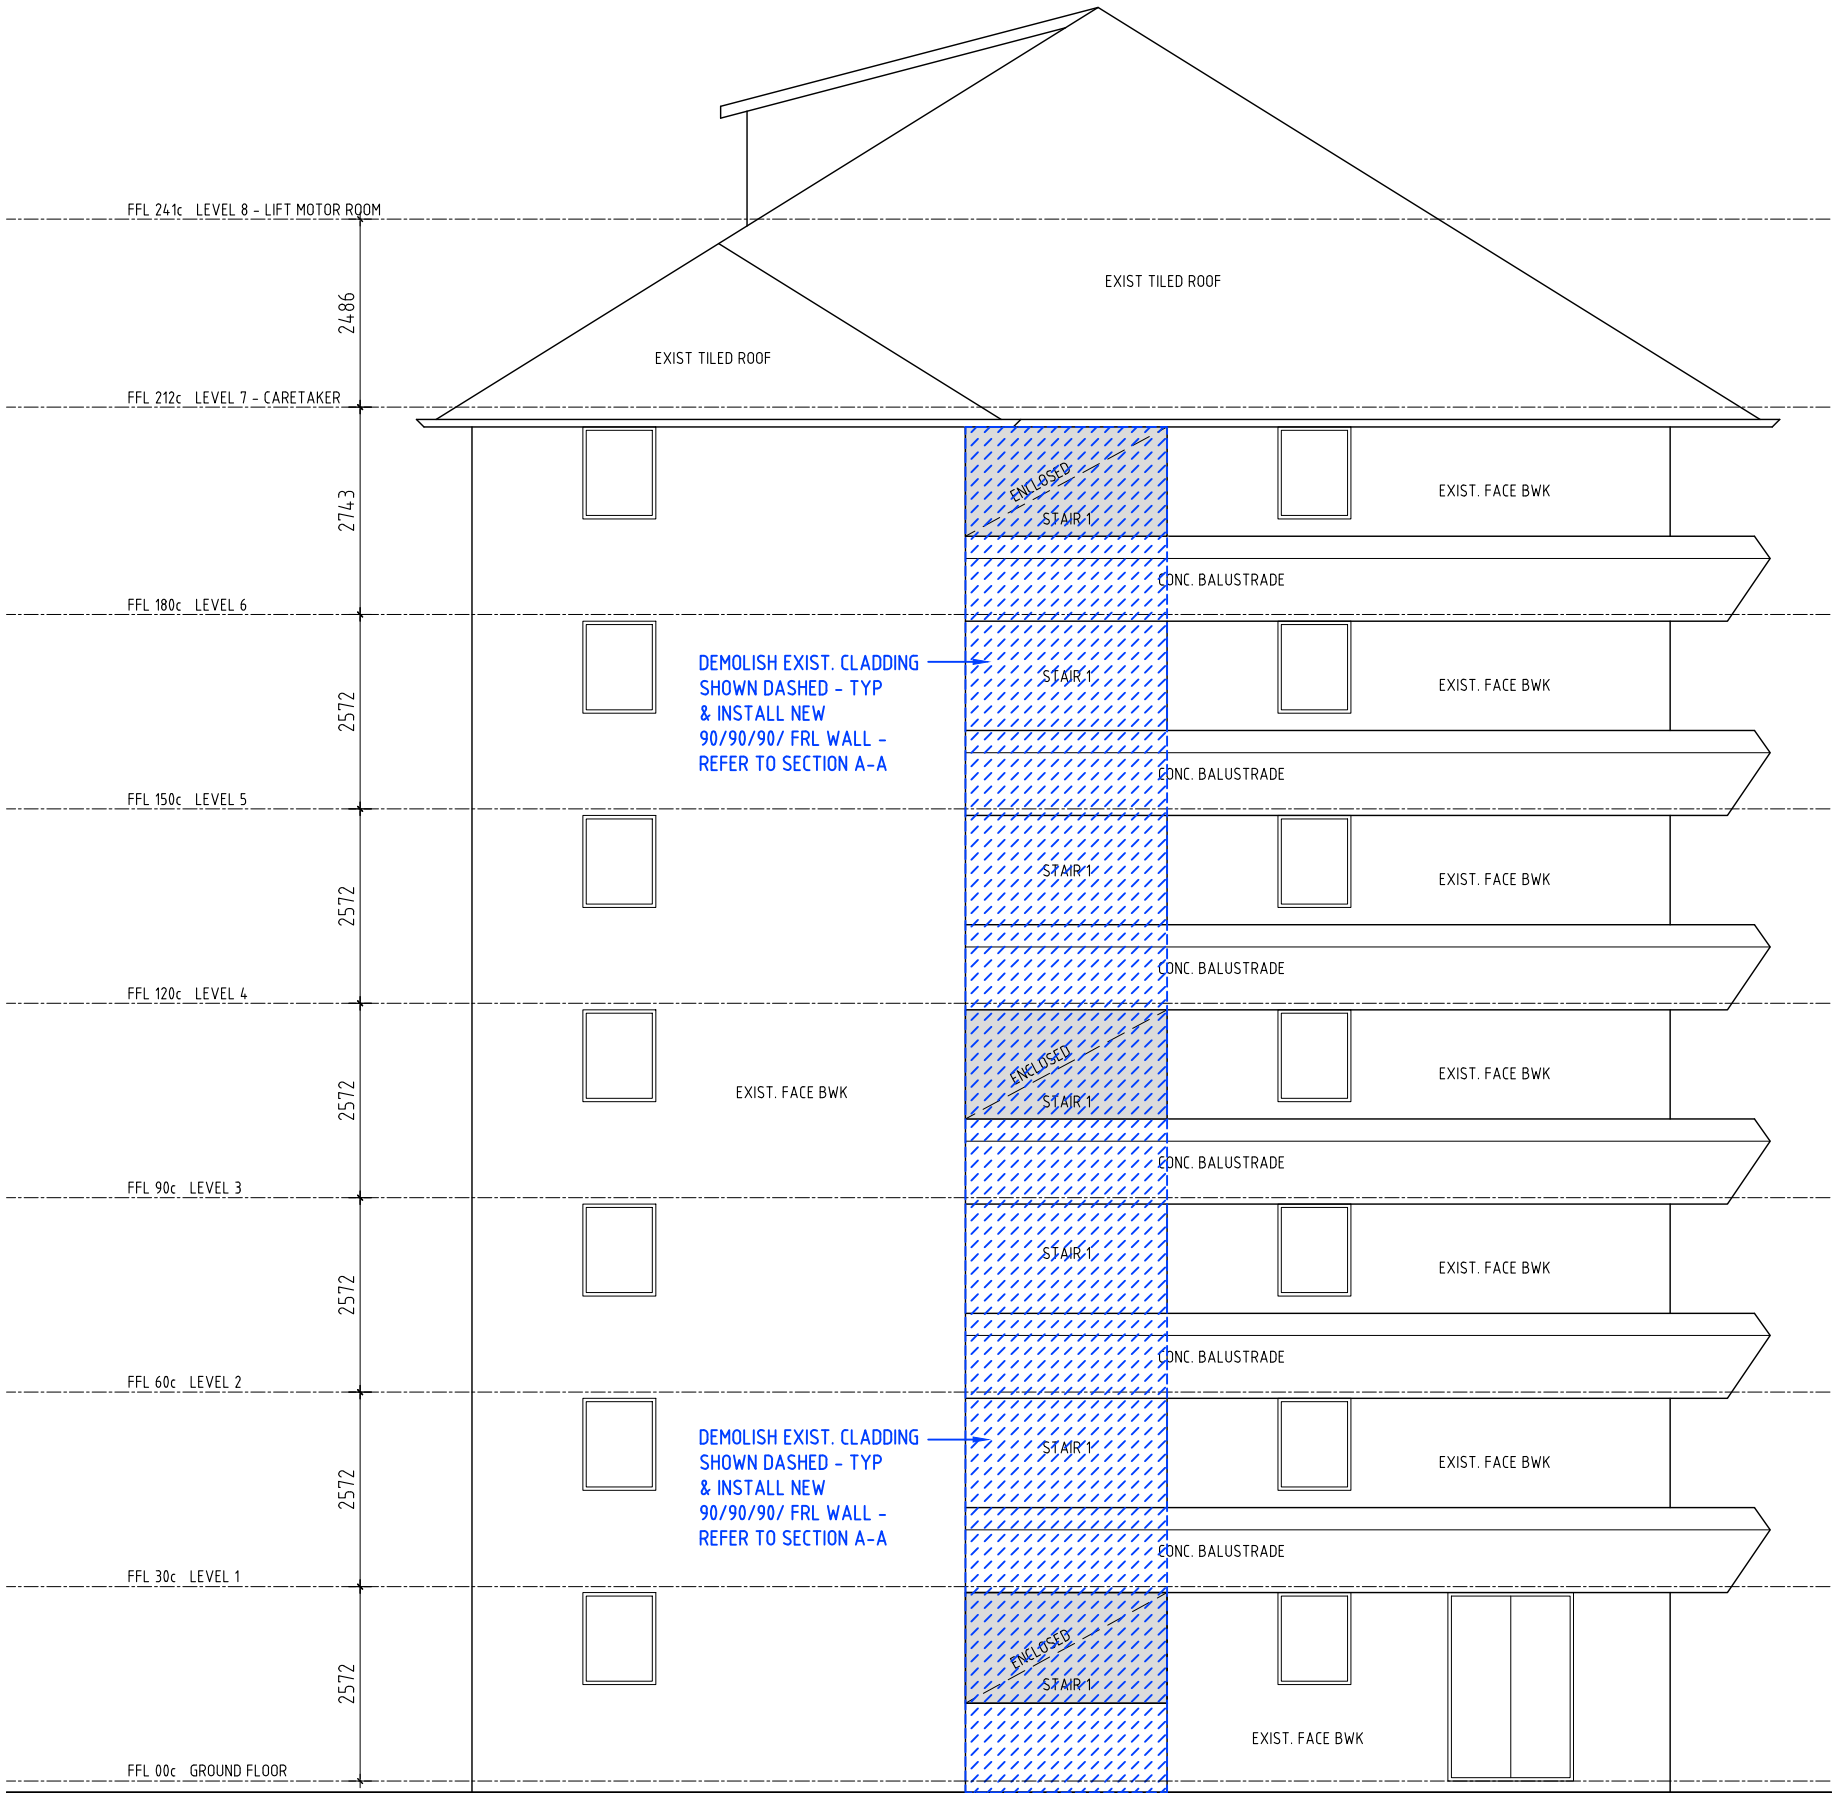

North East Elevation
Existing & Proposed
scale 1:100

NOTE:
MEASURE & CHECK ALL DIMENSIONS
ON SITE TO CONFIRM LAYOUT PRIOR TO
CONSTRUCTION

PRELIMINARY DRAWING
NOT FOR CONSTRUCTION

AS CONSTRUCTED
AS AT 22.02.2024

NOTE:
THESE ARE CAD CONVERSION DRAWINGS
FROM IMPERIAL AND ARE
NOT TO BE USED FOR
CONSTRUCTION PURPOSES


A	REV	DESCRIPTION	DATE
A	1	PRELIMINARY ISSUE	25.03.2024

VISTA DESIGNS
Building Designers
SUITE 3, 279 LORD STREET
EAST PERTH 6004
TEL./FAX: 92277415
© COPYRIGHT

SWAN CARE RICHARD CLEAVER LODGE
34 Graham Cres,
BENTLEY WA 6102

Drawn	Scale	Date	Job No.	Drawing No.	Rev
	1:100	25.03.24	3097	A9	A

Check all dimensions on site prior to commencement of any works
Unauthorized copying or distribution of this drawing is strictly
prohibited. Copyright © 2023

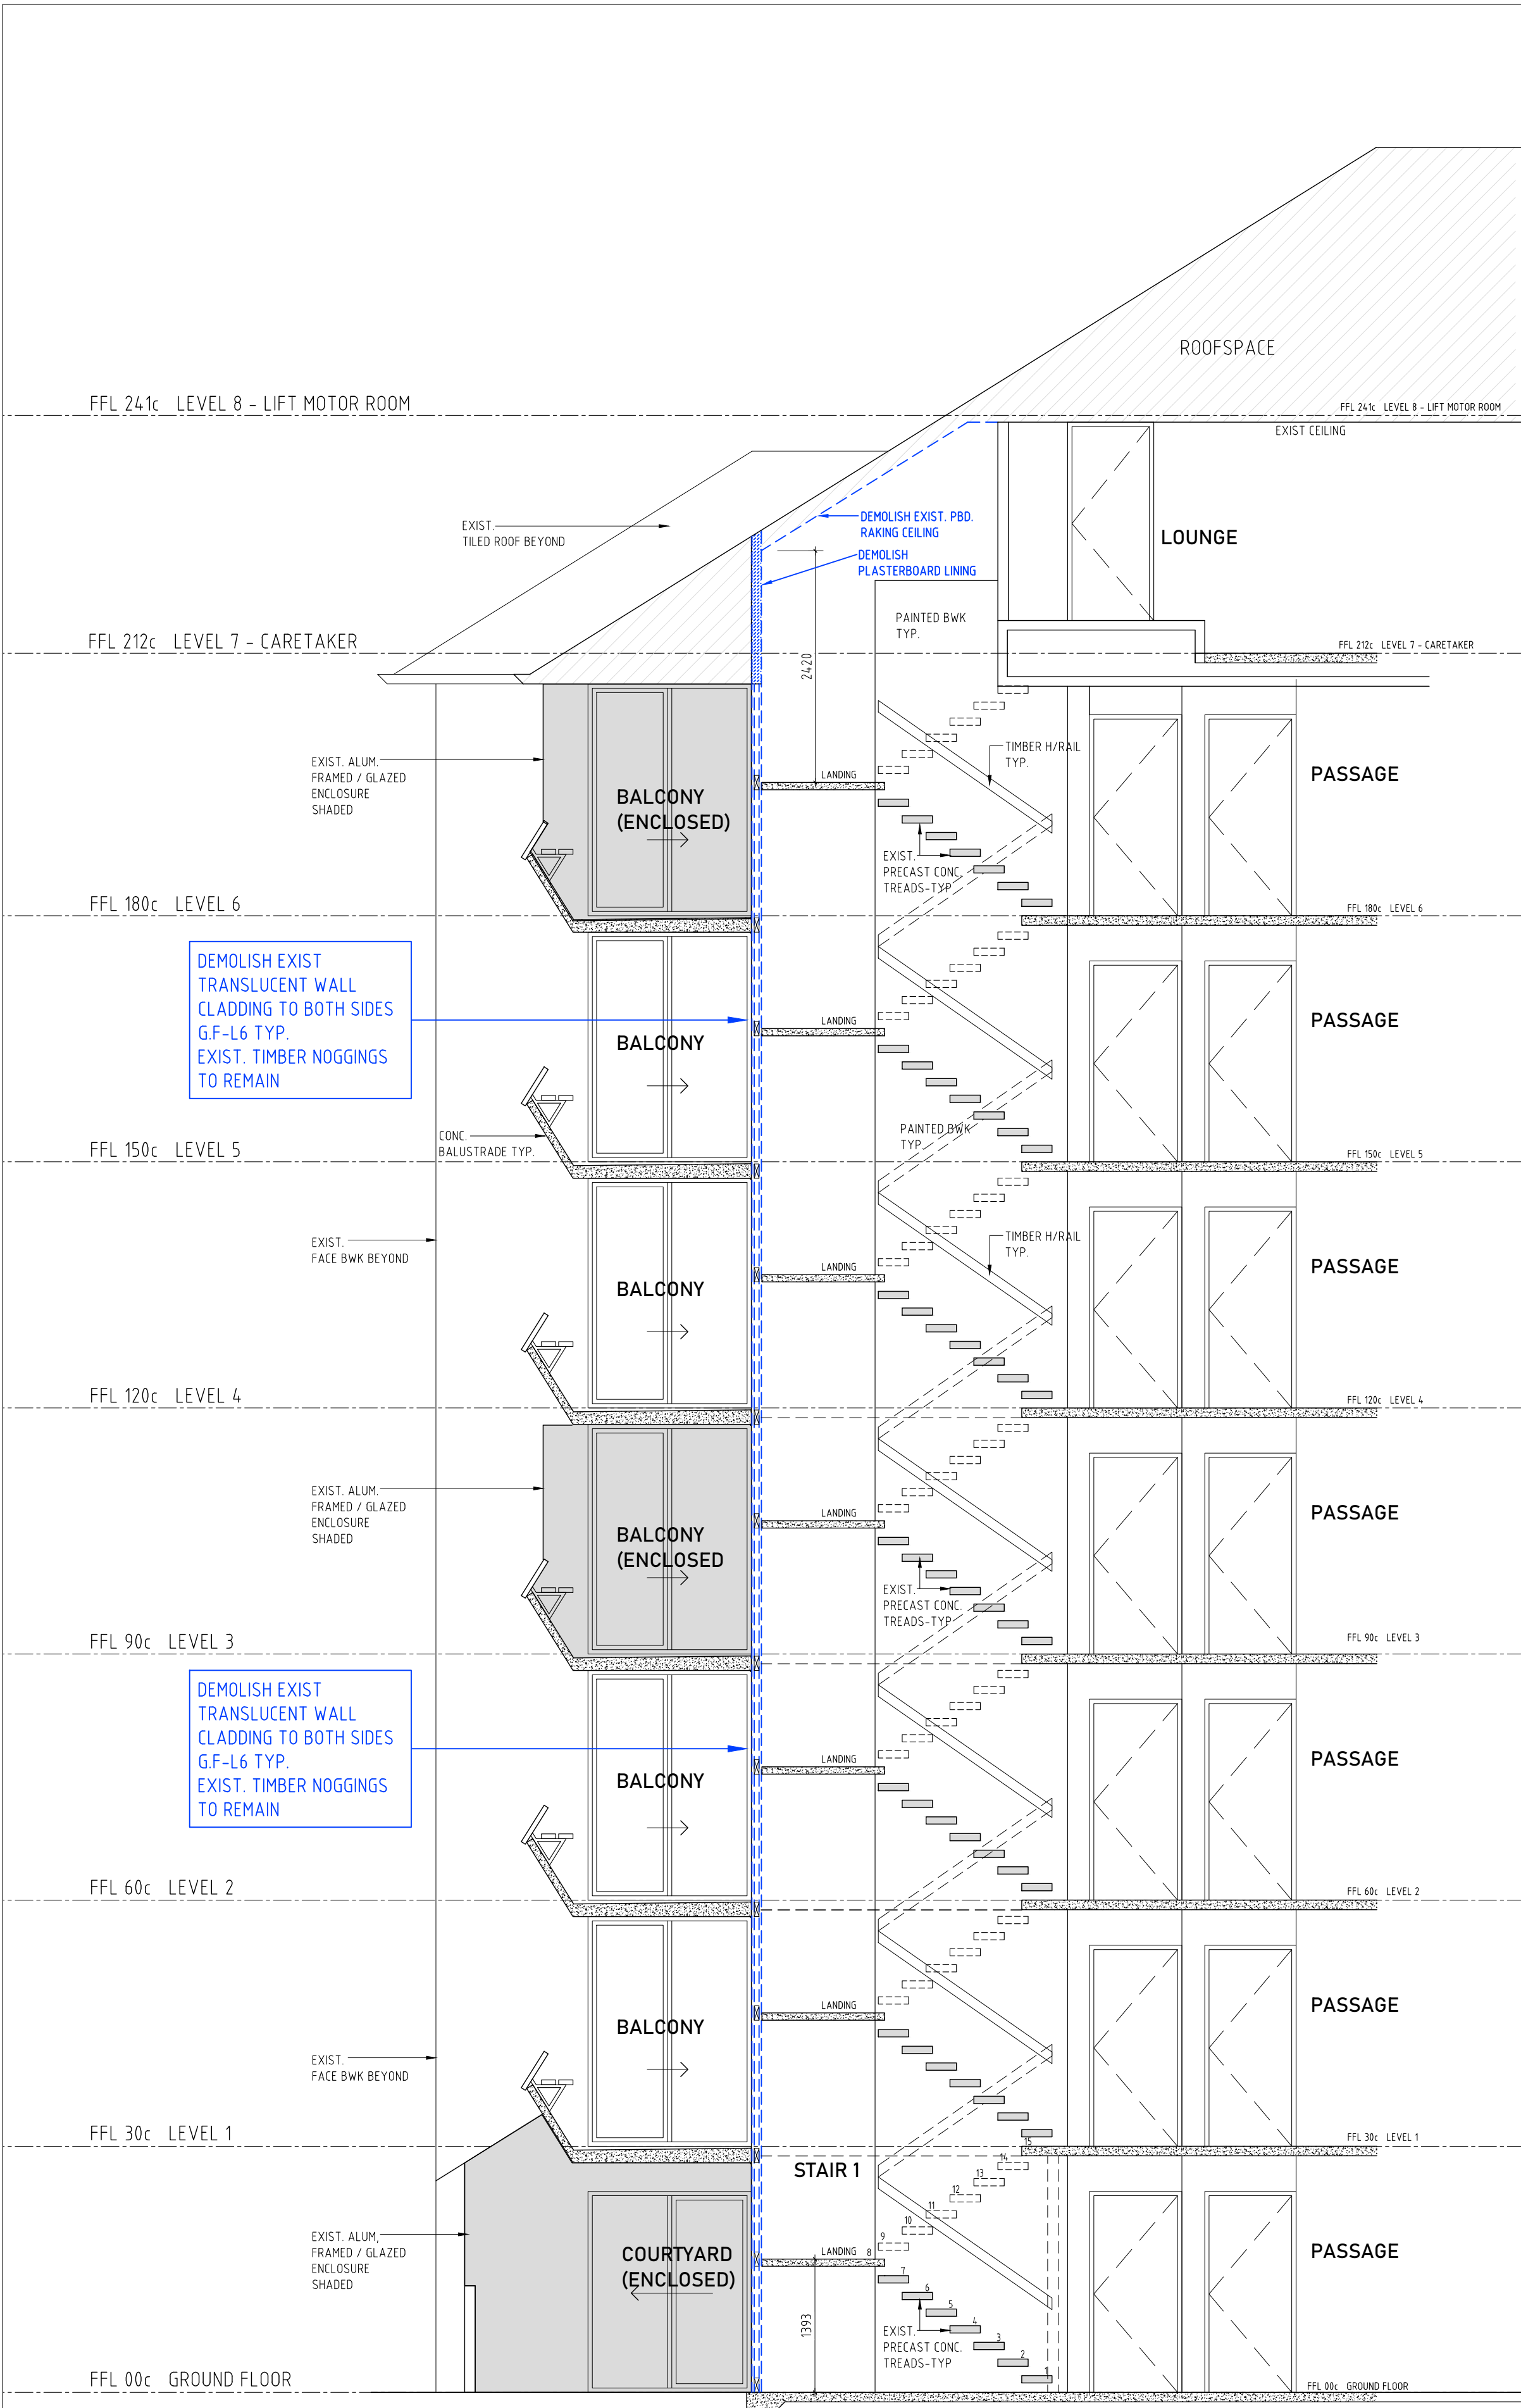

Part Section A-A
Existing / Demolition

scale 1:50

NOTE:
MEASURE & CHECK ALL DIMENSIONS
ON SITE TO CONFIRM LAYOUT PRIOR TO
CONSTRUCTION

GENERAL NOTES

- PAINT TO ALL NEW WALLS & CEILINGS TO AS/NZS 2311:2017
- DO NOT SCALE DRAWING - DIMENSIONS TO GOVERN SCALE
- ALL DIMENSIONS ARE TO BE CHECKED ON SITE PRIOR TO THE COMMENCEMENT OF ANY WORK OR THE FABRICATION OF ANY ITEMS
- ALL MATERIALS ARE TO BE INSTALLED IN ACCORDANCE WITH THE 'NCC' & MANUFACTURER'S RECOMMENDATIONS UNLESS NOTED OTHERWISE
- EXTENT OF DEMOLITION NOT LIMITED TO AS FINISHED & MAKE GOOD TO ALL EXISTING ADJOINING FINISHES
- THIS DRAWING SHALL BE READ IN CONJUNCTION & COMPLY WITH THE FOLLOWING:
 - HVAC DRAWINGS BY OTHERS
 - ELECTRICAL DRAWINGS BY OTHERS
 - FIRE ENGINEER'S REPORTS
 - AS 1428 CODE REQUIREMENTS
 - MANUFACTURER'S SPECIFICATIONS
 - 'NCC' REQUIREMENTS

PRELIMINARY DRAWING
NOT FOR CONSTRUCTION

AS CONSTRUCTED
AS AT 22.02.2024

NOTE:
THESE ARE CAD CONVERSION DRAWINGS
FROM IMPERIAL AND ARE
NOT TO BE USED FOR
CONSTRUCTION PURPOSES

REV	DESCRIPTION	DATE
A	PRELIMINARY ISSUE	25.03.2024

VISTA DESIGNS
Building Designers


SUITE 3, 279 LORD STREET
EAST PERTH 6004
TEL./FAX: 92277415
© COPYRIGHT

SWAN CARE RICHARD CLEAVER LODGE
34 Graham Cres,
BENTLEY WA 6102

Part Section A-A - Existing / Demolition

Drawn	Scale 1:500	Date 25.03.24	Job No. 3097	Drawing No.	Rev
Check all dimensions on site prior to commencement of any works Unauthorised copying or distribution of this drawing is strictly prohibited. Copyright © 2023				A10	A

Check all dimensions on site prior to commencement of any works
Unauthorized copying or distribution of this drawing is strictly
prohibited. Copyright © 2023

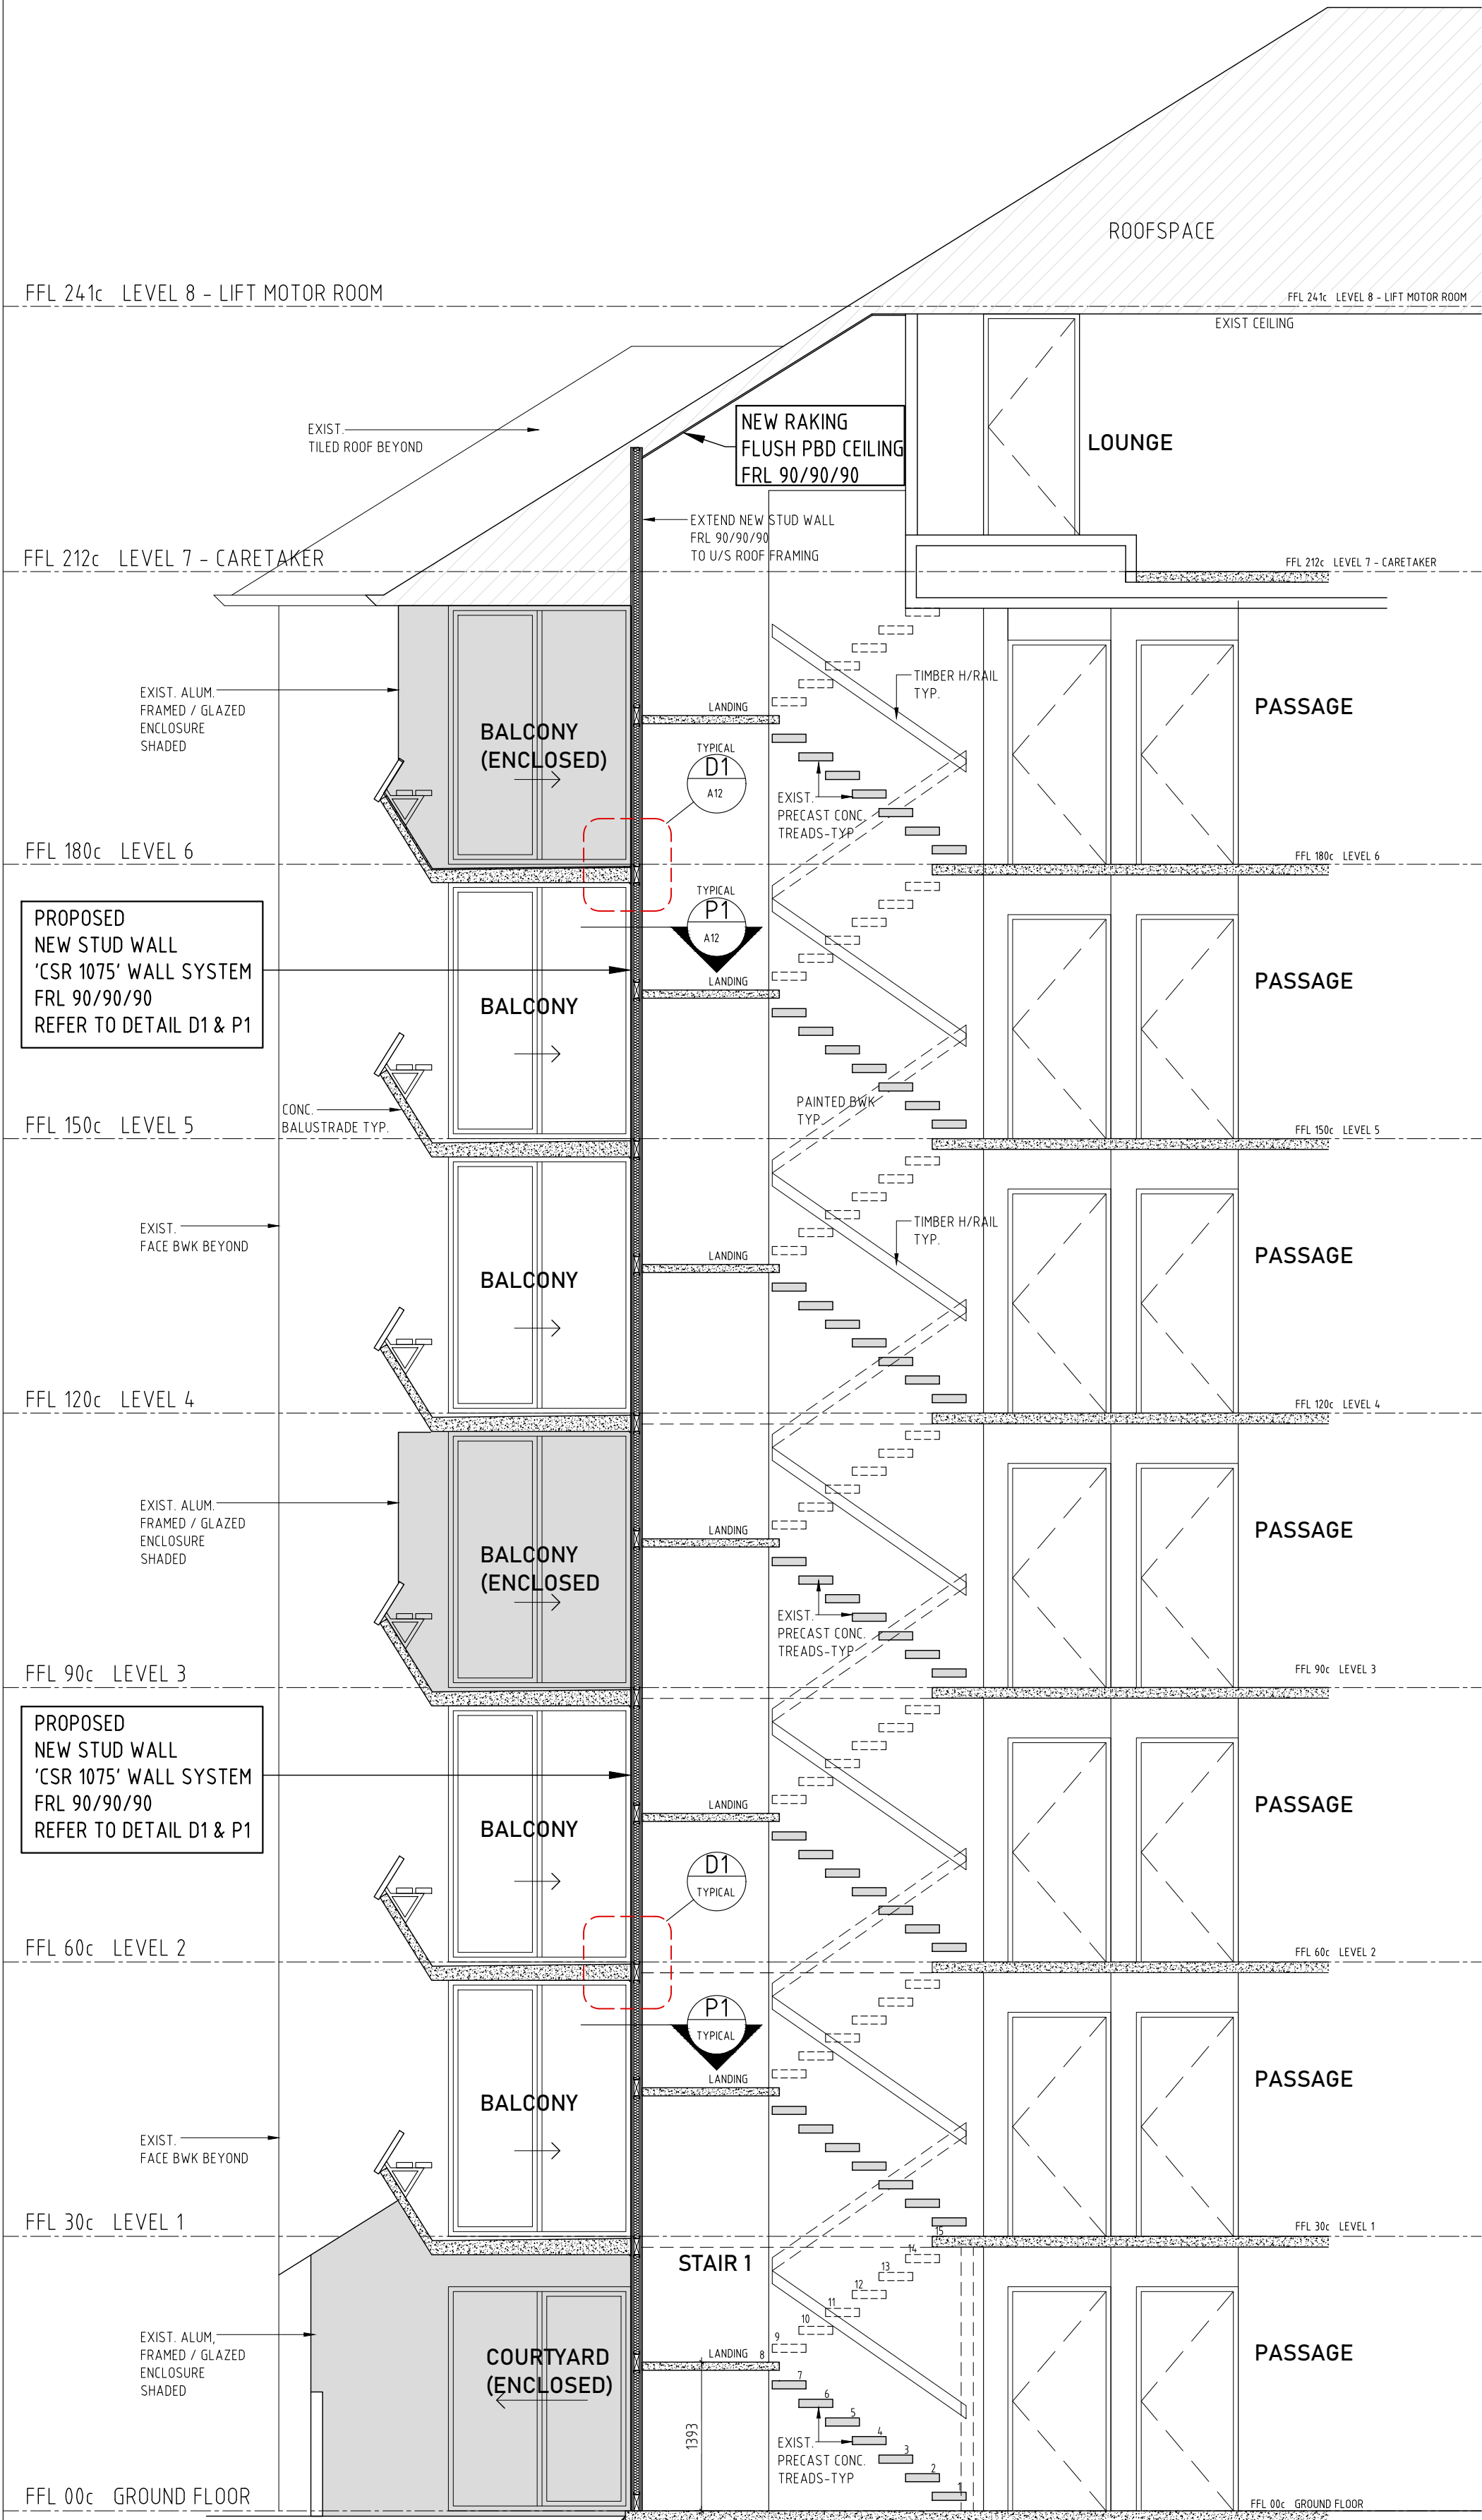

Part Section A-A Proposed Upgrade Works

scale 1:50

GENERAL NOTES

- PAINT TO ALL NEW WALLS & CEILINGS TO AS/NZS 2311:2017
- DO NOT SCALE DRAWING - DIMENSIONS TO GOVERN SCALE
- ALL DIMENSIONS ARE TO BE CHECKED ON SITE PRIOR TO THE COMMENCEMENT OF ANY WORK OR THE FABRICATION OF ANY ITEMS
- ALL MATERIALS ARE TO BE INSTALLED IN ACCORDANCE WITH THE 'NCC' & MANUFACTURER'S RECOMMENDATIONS UNLESS NOTED OTHERWISE
- EXTENT OF DEMOLITION NOT LIMITED TO AS STATED & MAKE GOOD TO ALL EXISTING ADJOINING FINISHES
- THIS DRAWING SHALL BE READ IN CONJUNCTION & COMPLY WITH THE FOLLOWING:
 - HVAC DRAWINGS BY OTHERS
 - ELECTRICAL DRAWINGS BY OTHERS
 - FIRE ENGINEER'S REPORTS
 - AS 1428 CODE REQUIREMENTS
 - MANUFACTURER'S SPECIFICATIONS
 - 'NCC' REQUIREMENTS



**PRELIMINARY DRAWING
NOT FOR CONSTRUCTION**

**NOTE:
THESE ARE CAD CONVERSION DRAWINGS
FROM IMPERIAL AND ARE
NOT TO BE USED FOR
CONSTRUCTION PURPOSES**

NOTE:
MEASURE & CHECK ALL DIMENSIONS
ON SITE TO CONFIRM LAYOUT PRIOR TO
CONSTRUCTION

VISTA DESIGNS
Building Designers
SUITE 3, 279 LORD STREET
EAST PERTH 6004
TEL / FAX: 92277415
© COPYRIGHT

Drawing Title				
SWAN CARE RICHARD CLEAVER LODGE 34 Graham Cres, BENTLEY WA 6102				
Part Section A-A - Proposed Upgrade				
Drawn	Scale	Date	Job No.	Drawing No.
150, 1:100	25.03.24	3097		
Check all dimensions on site prior to commencement of any works Unauthorized copying or distribution of this drawing is strictly prohibited. Copyright © 2023				Rev
				A11
				A

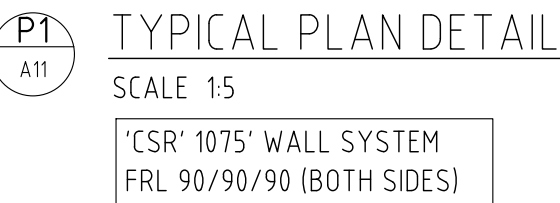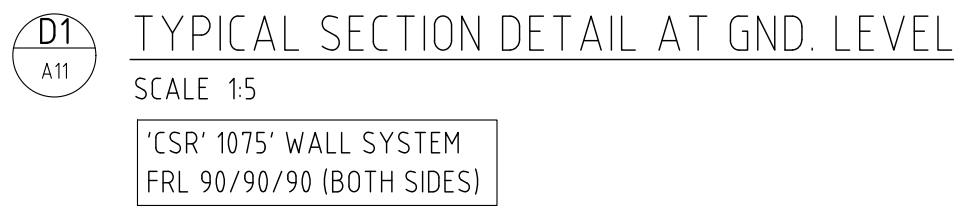

- PAINT TO ALL NEW WALLS & CEILINGS TO AS/NZS 2311:2017
- DO NOT SCALE DRAWING – DIMENSIONS TO GOVERN SCALE
- ALL DIMENSIONS ARE TO BE CHECKED ON SITE PRIOR TO THE COMMENCEMENT OF ANY WORK OR THE FABRICATION OF ANY ITEMS
- ALL MATERIALS ARE TO BE INSTALLED IN ACCORDANCE WITH THE 'NCC' & MANUFACTURER'S RECOMMENDATIONS UNLESS NOTED OTHERWISE
- EXTENT OF DEMOLITION NOT LIMITED TO AS STATED & MAKE GOOD TO ALL EXISTING ADJOINING FINISHES
- THIS DRAWING SHALL BE READ IN CONJUNCTION & COMPLY WITH THE FOLLOWING:
 - HVAC DRAWINGS BY OTHERS
 - ELECTRICAL DRAWINGS BY OTHERS
 - FIRE ENGINEER'S REPORTS
 - AS 1428 CODE REQUIREMENTS
 - MANUFACTURER'S SPECIFICATIONS
 - 'NCC' REQUIREMENTS

NOTE:
MEASURE & CHECK ALL DIMENSIONS
ON SITE TO CONFIRM LAYOUT PRIOR TO
CONSTRUCTION

	REV	DESCRIPTION	DATE	DRAWN
VISTA DESIGNS <i>Building Designers</i> SUITE C, 279 LORD STREET EAST PERTH 6004 TEL./FAX: 92277415 © COPYRIGHT	SWAN CARE RICHARD CLEVER LODGE 34 Graham Cres, BENTLEY WA 6102			
	Drawing Title			
	Construction Details - Proposed Upgrade			
Drawn	Scale 1:50A2	Date 25.03.24	Job No. 3097	Drawing No.
Check all dimensions on site prior to commencement of any works Unauthorised copying or distribution of this drawing is strictly prohibited. © Copyright 2013				A12